






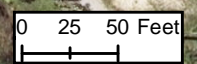


Legend

-  1-Manhole
-  ssGravityMain
- ssLateralLine**
- SUBTYPE**
-  2-Cleanout Lateral
-  1-Service Line
-  wHydrant
- wLateralLines**
-  wLateralLines
-  wPressurizedMain



RPB COMMONS WATER AND SEWER

