

ADDENDUM NO. 3

To: ALL PLAN HOLDERS September 2, 2016

Re:

INTERIOR TENANT IMPROVEMENT FOR: IMMUNOTEK BIO CENTERS, LLC 4560 LAKE WORTH ROAD OFFICE DEPOT PLAZA, SUITE B-5 LAKE WORTH, PALM BEACH COUNTY, FL 33463

NOTICE TO BIDDERS AND/OR INTEREST CONCERNS

The Addendum shall be considered part of the Contract Documents for the above referenced project as though it had been issued at the same time and shall be incorporated integrally therewith. Where provisions of the following supplementary data differ from those of the original Contract Documents, this addendum shall govern and take precedence.

Bidders are hereby notified that they shall make any necessary adjustment in their estimate on account of this Addendum. It will be construed that each Bidder's Proposal is submitted with full knowledge of all modifications and supplemental data specified herein. Bidder shall acknowledge this Addendum in the bid form.

ADDENDUM ITEMS:

Item 1. ARCHITECTURAL:

- 1) Sheet **RA1.2 General Information**
 - a. Revised 2 Life Safety plan
- 2) Sheet **RA3.1 Demolition Plan**
 - a. Add Demolition Plan Keynote 16 and
 - b. Located Note 16 on 18 Demolition Plan
- 3) Sheet **RA3.2 Labeled Plan**
 - a. Revise Renovation Plan Keynote 21
 - b. Relocate Note 21 on 18 Labeled Plan
 - c. Relocate TV in Waiting 104 on 18 Labeled Plan
 - d. Eliminate Sprinkler 133 on 18 Labeled Plan
 - e. Move I.T. 124 on 18 Labeled Plan
 - f. Enlarge Sterile Supplies 128 on 18 Labeled Plan
 - g. Make correction to 16 Column Detail Plan

105 CHAPEL DRIVE - LAFAYETTE, LOUISIANA 70506 337.988.5271 ph - 337.988.5272 fax www.ackalarchitects.com



ARCHITECTS

- h. Make correction to 17 Column Detail Plan
- 4) Sheet **RA3.3 Dimensioned Plan**
 - a. Revise dimensions on 18 Dimension Plan to correspond with Eliminating Sprinkler 133, Moving I.T. 124 and Enlarging Sterile Supplies 128
- 5) Sheet RA3.4 Reflected Ceiling Plan
 - a. Revise ceiling grid on 18 Reflected Ceiling Plan to correspond with Eliminating Sprinkler 133, Moving I.T. 124 and Enlarging Sterile Supplies 128
- 6) Sheet RA5.1 Room Finish Schedule
 - a. Eliminate Sprinkler 133 on Room Finish Schedule
 - b. Revise FRP on 1 Wall Finish Key Plan to correspond with Eliminating Sprinkler 133, Moving I.T. 124 and Enlarging Sterile Supplies 128
- 7) Sheet **RA5.2 Door Schedule**
 - a. Eliminate Door 133-A on Door Schedule
 - b. Eliminate Door 133-A on Door Hardware Schedule
- 8) Sheet **RA8.1 Details**
 - a. Revised sidewalk that sloped to existing drive on 16 Canopy Plan


Item 2. ELECTRICAL:


- 1) Sheet **E0.0 Symbol List and General Notes**
 - a. Revised Drawing Index
- 2) Sheet **E0.2 Panel Schedules**
 - a. Revised schedules per floor plan changes
- 3) Sheet **E2.0 Power Plan**
 - a. Added exhaust fans at freezers.
 - b. Revised outlet locations per revised architectural drawings
- 4) Sheet **E2.1 Signal Plan**
 - a. Revised outlet locations per revised architectural drawings
- 5) Sheet **E2.2 Lighting Plan**
 - a. Revised fixture locations per revised architectural drawings
- 6) Sheet **E2.3 Electrical Roof Plan**
 - a. Revised CU location

Item 3. MECHANICAL:

- 7) Sheet MP0.0 Symbol List and Abbreviations
 - a. Revised Drawing Index
- 8) Sheet **MP0.2 Mechanical Schedules**
 - a. Removed Electric Unit Heater schedule
- 9) Sheet **M2.0 Mechanical Plan**
 - a. Revised mechanical drawing to suit new architectural background
 - b. Relocated FC-1 and removed UH-1
- 10) Sheet MP2.3 Mechanical and Plumbing Roof Plan
 - a. Relocated CU-1

END OF ADDENDUM NO. 3

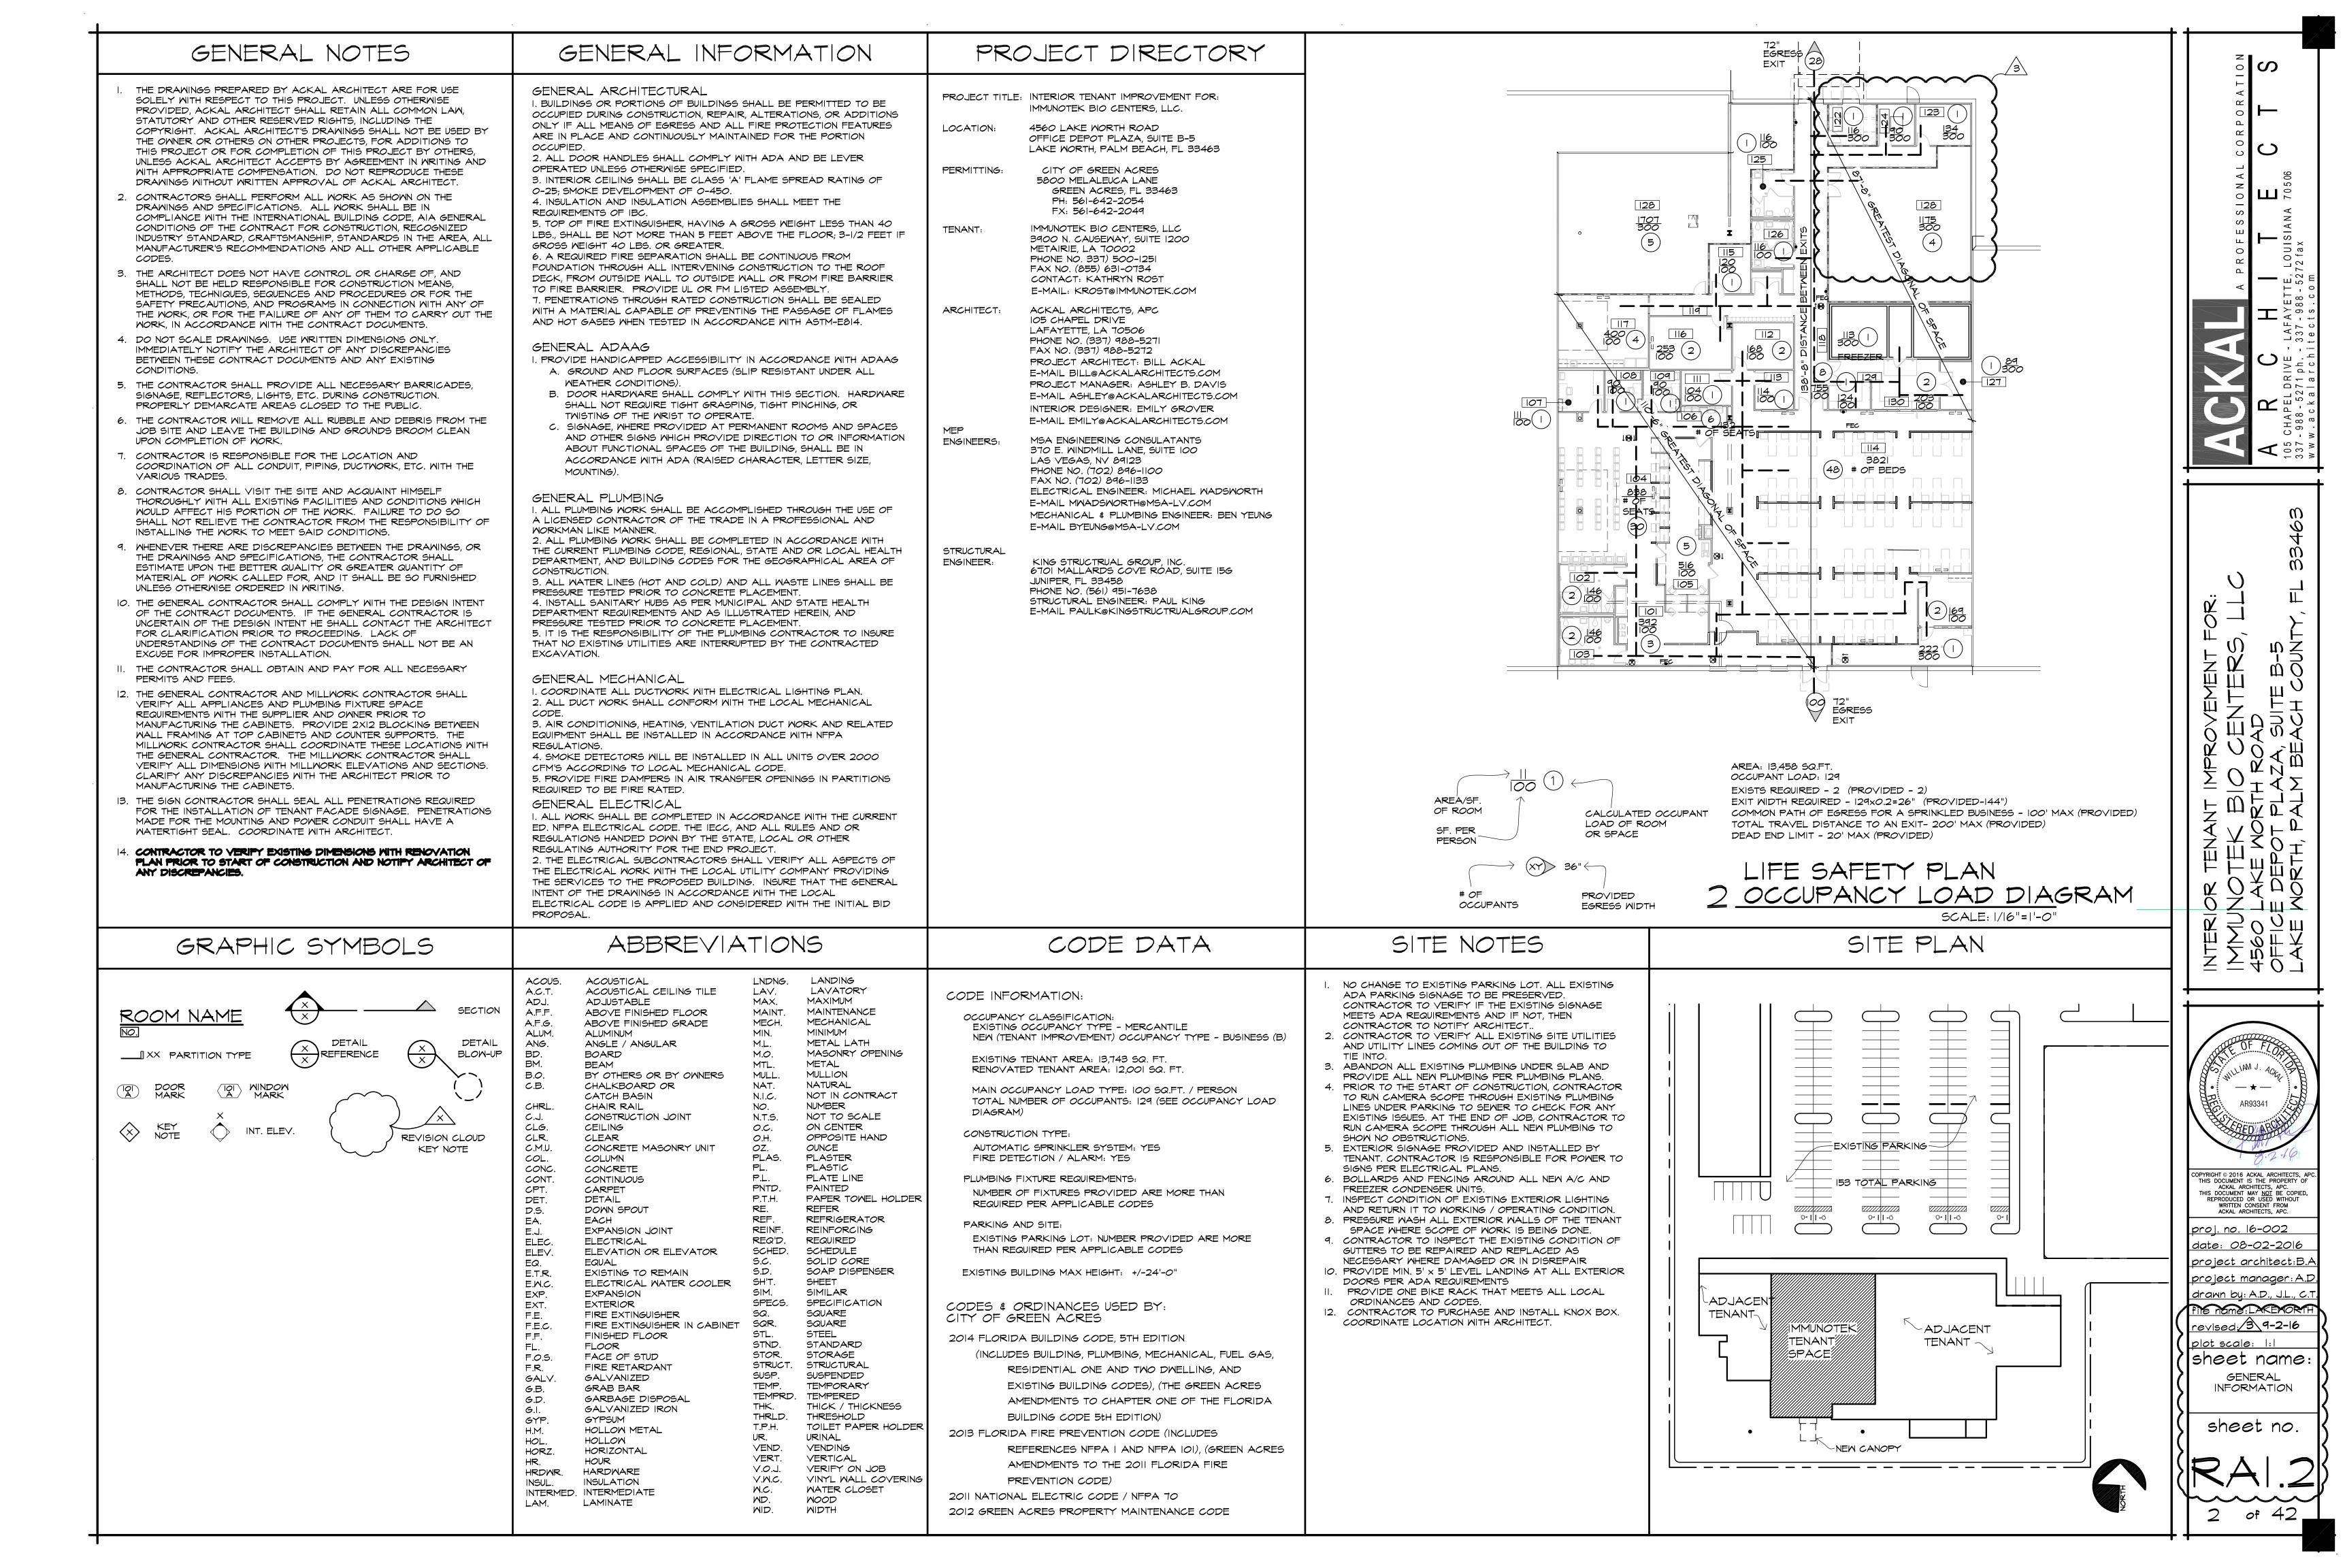

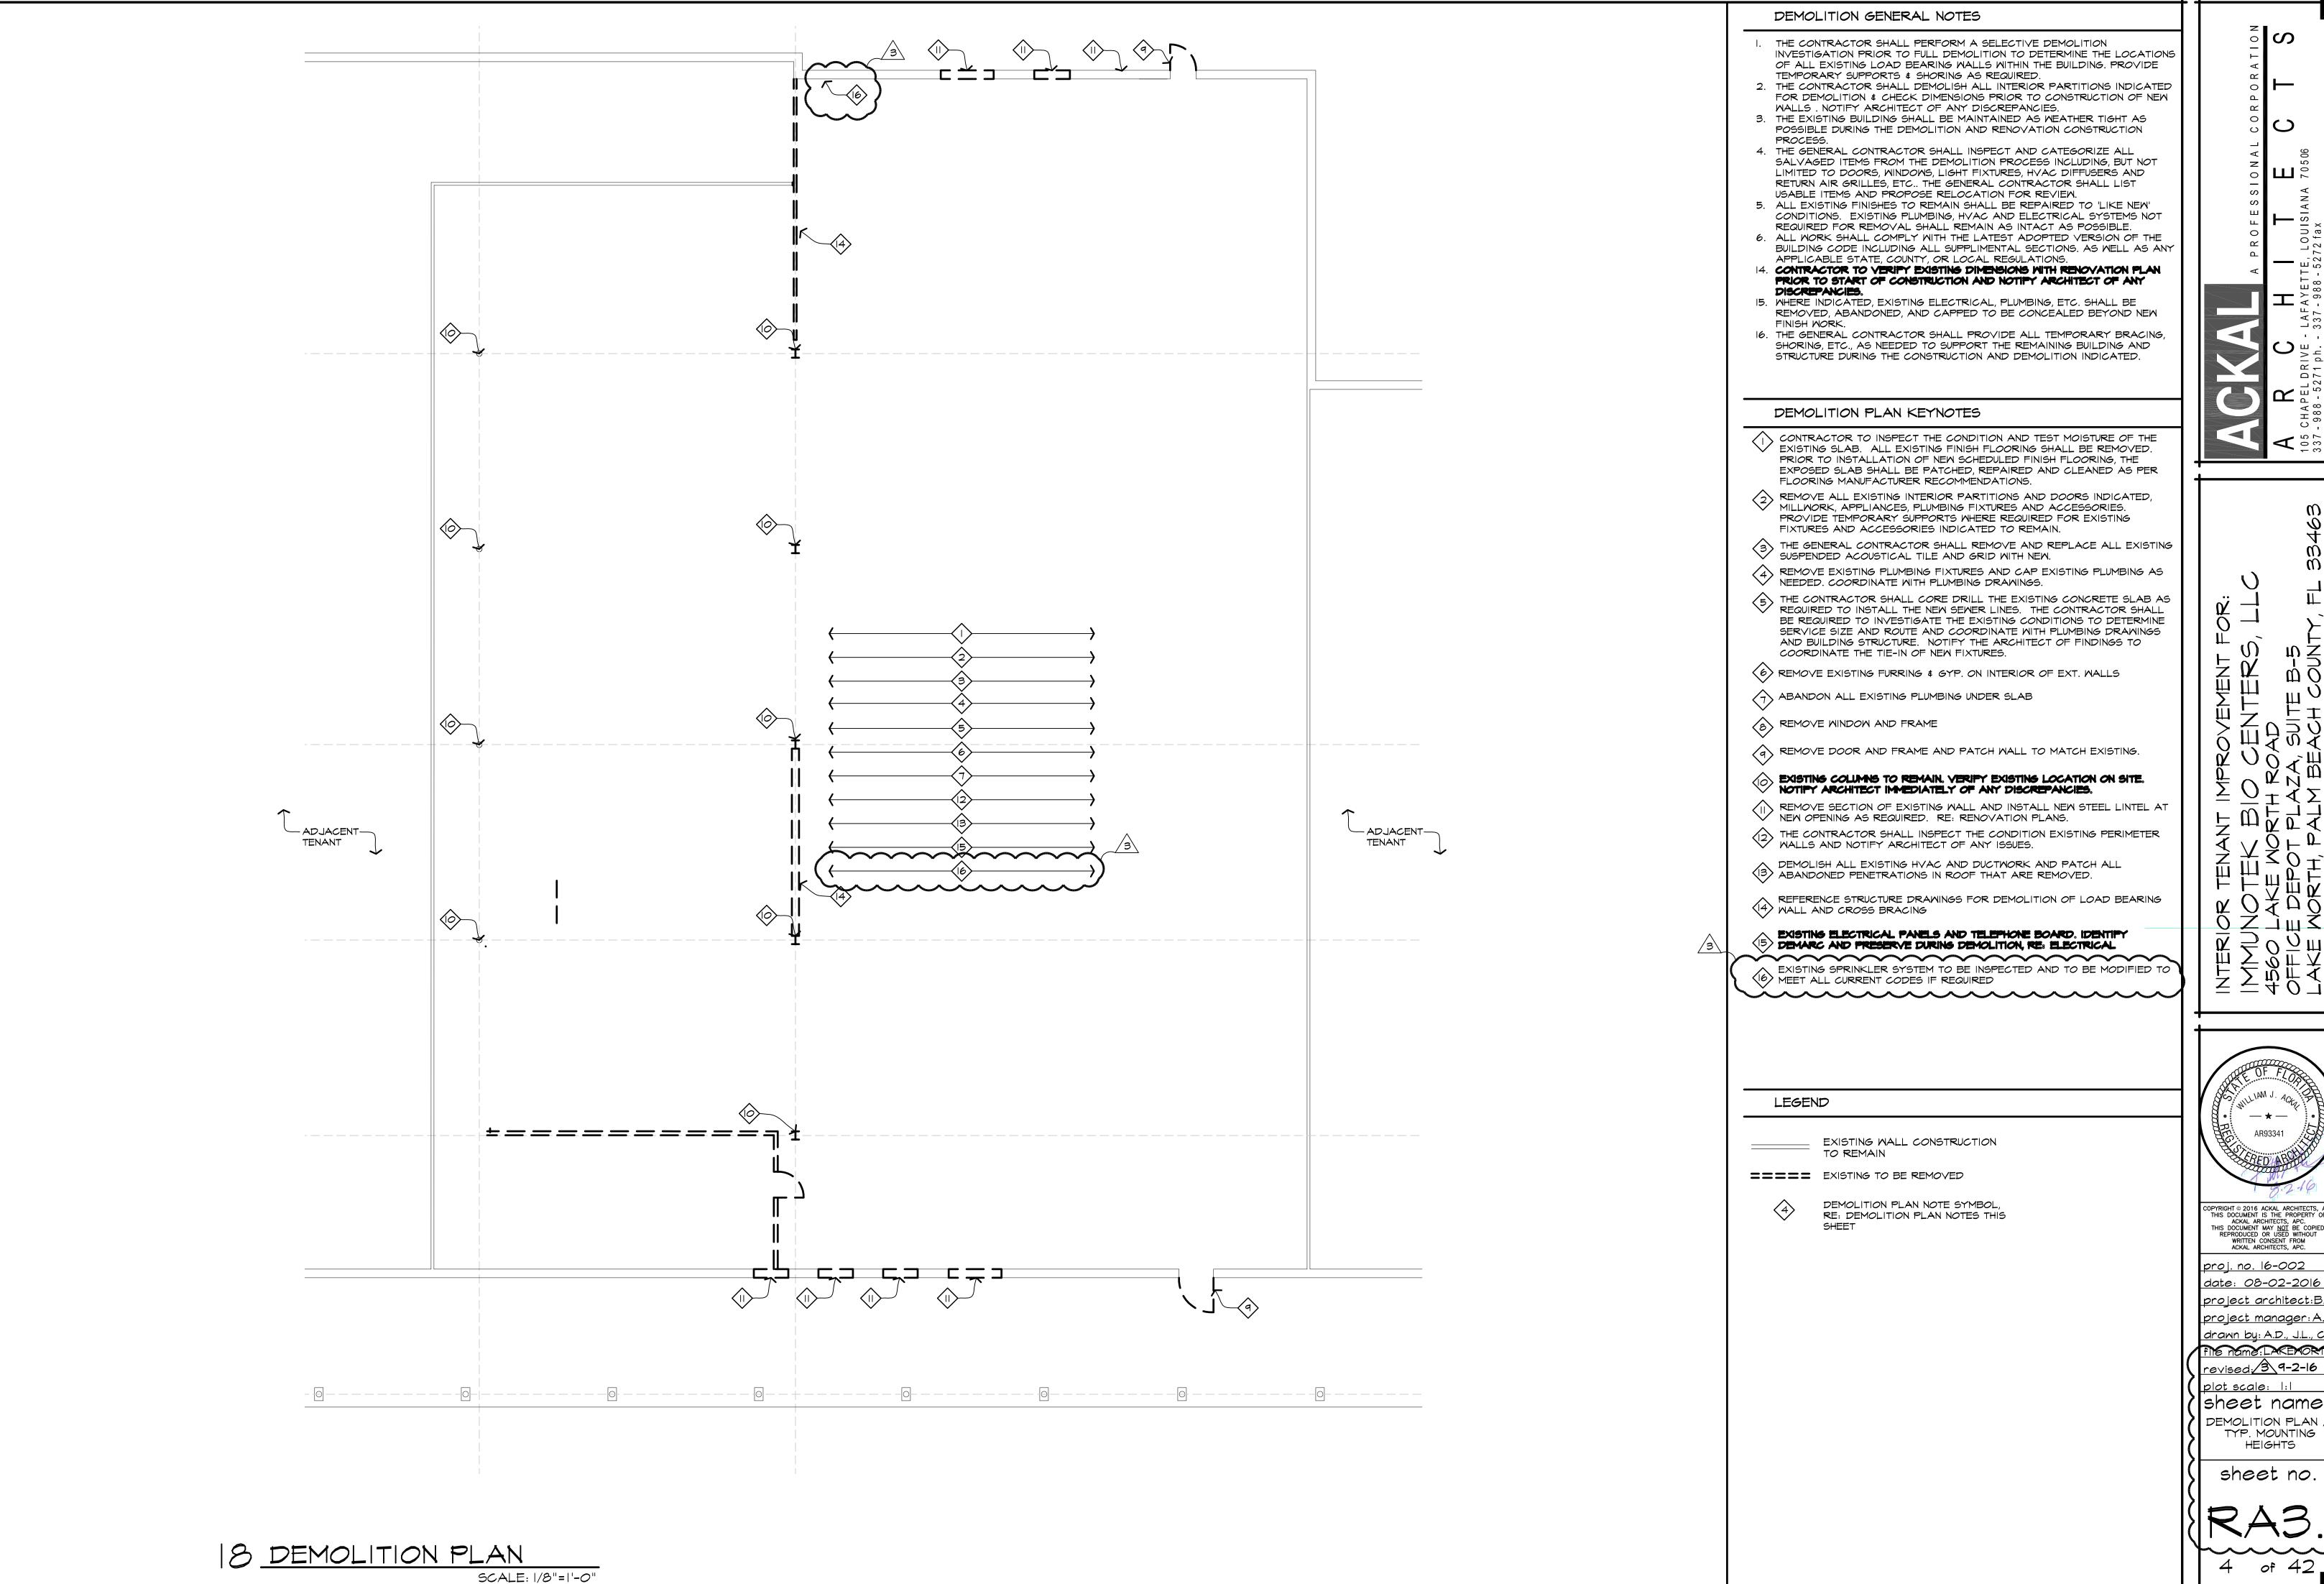



date: 08-02-2016 <u>project architect:B</u> project manager: A. drawn by: A.D., J.L., C FINE NAME: LAKENORY revised:/3 9-2-16


plot scale: |:| |sheet name:

HEIGHTS

sheet no

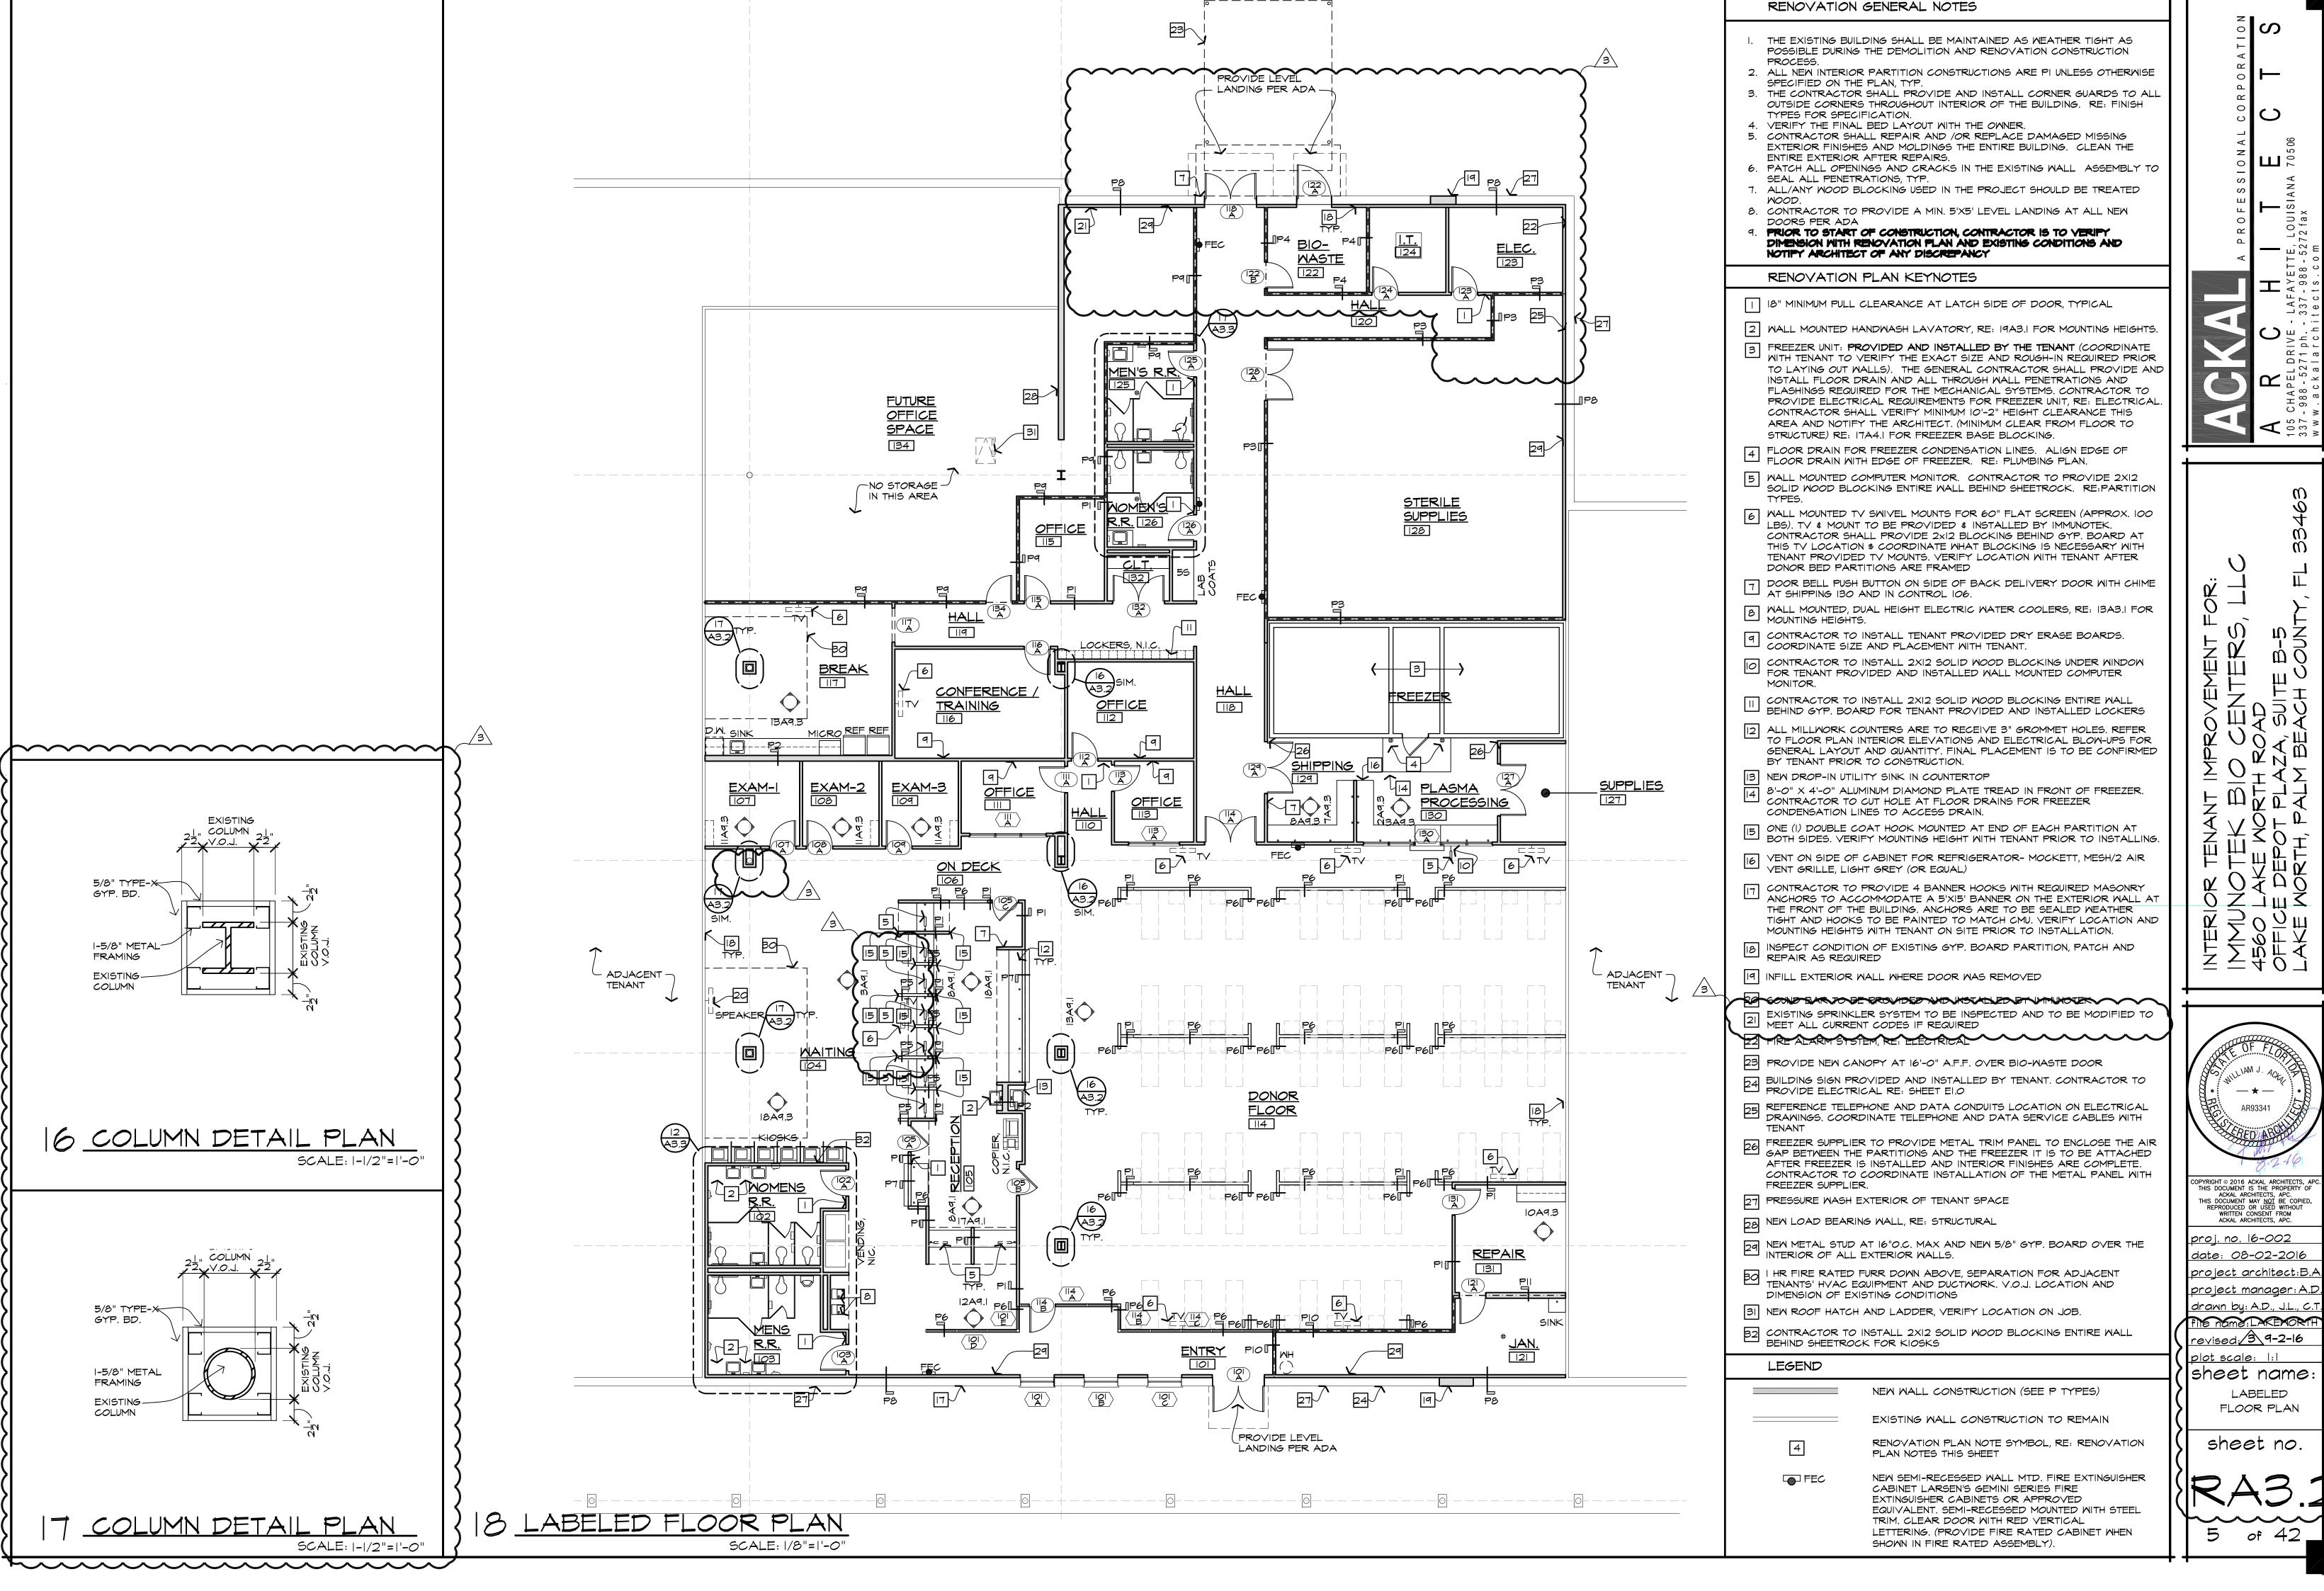

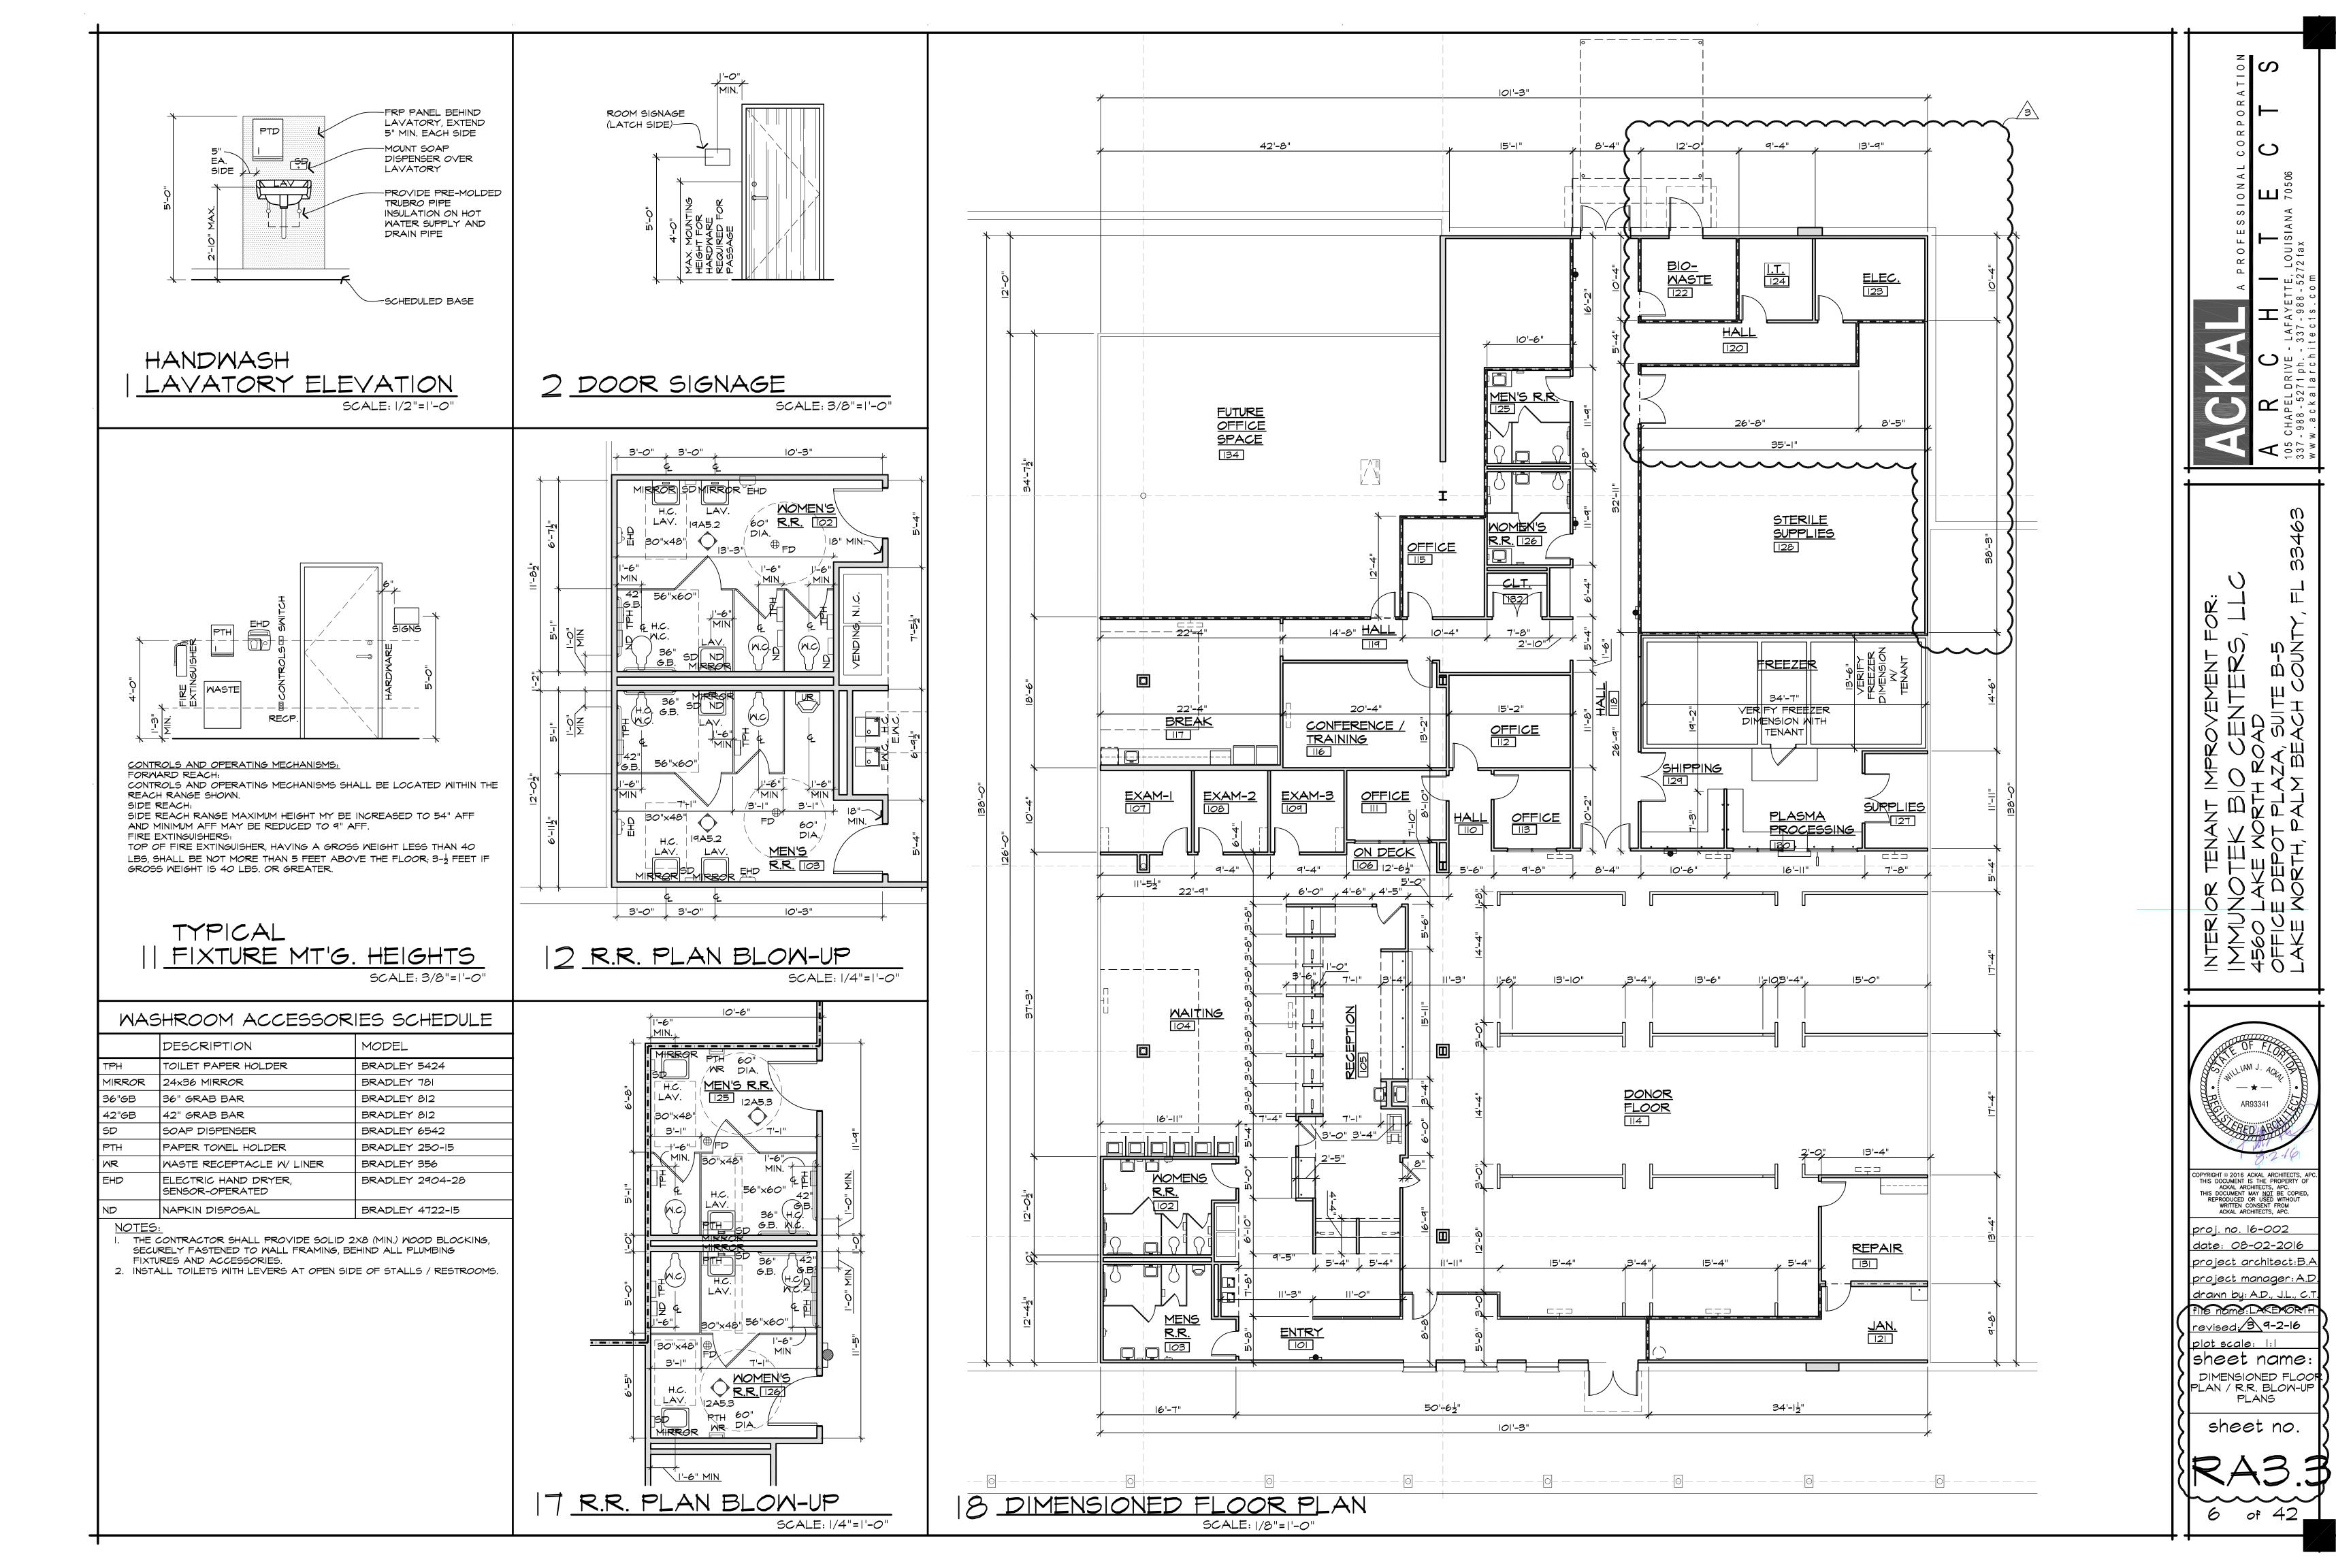


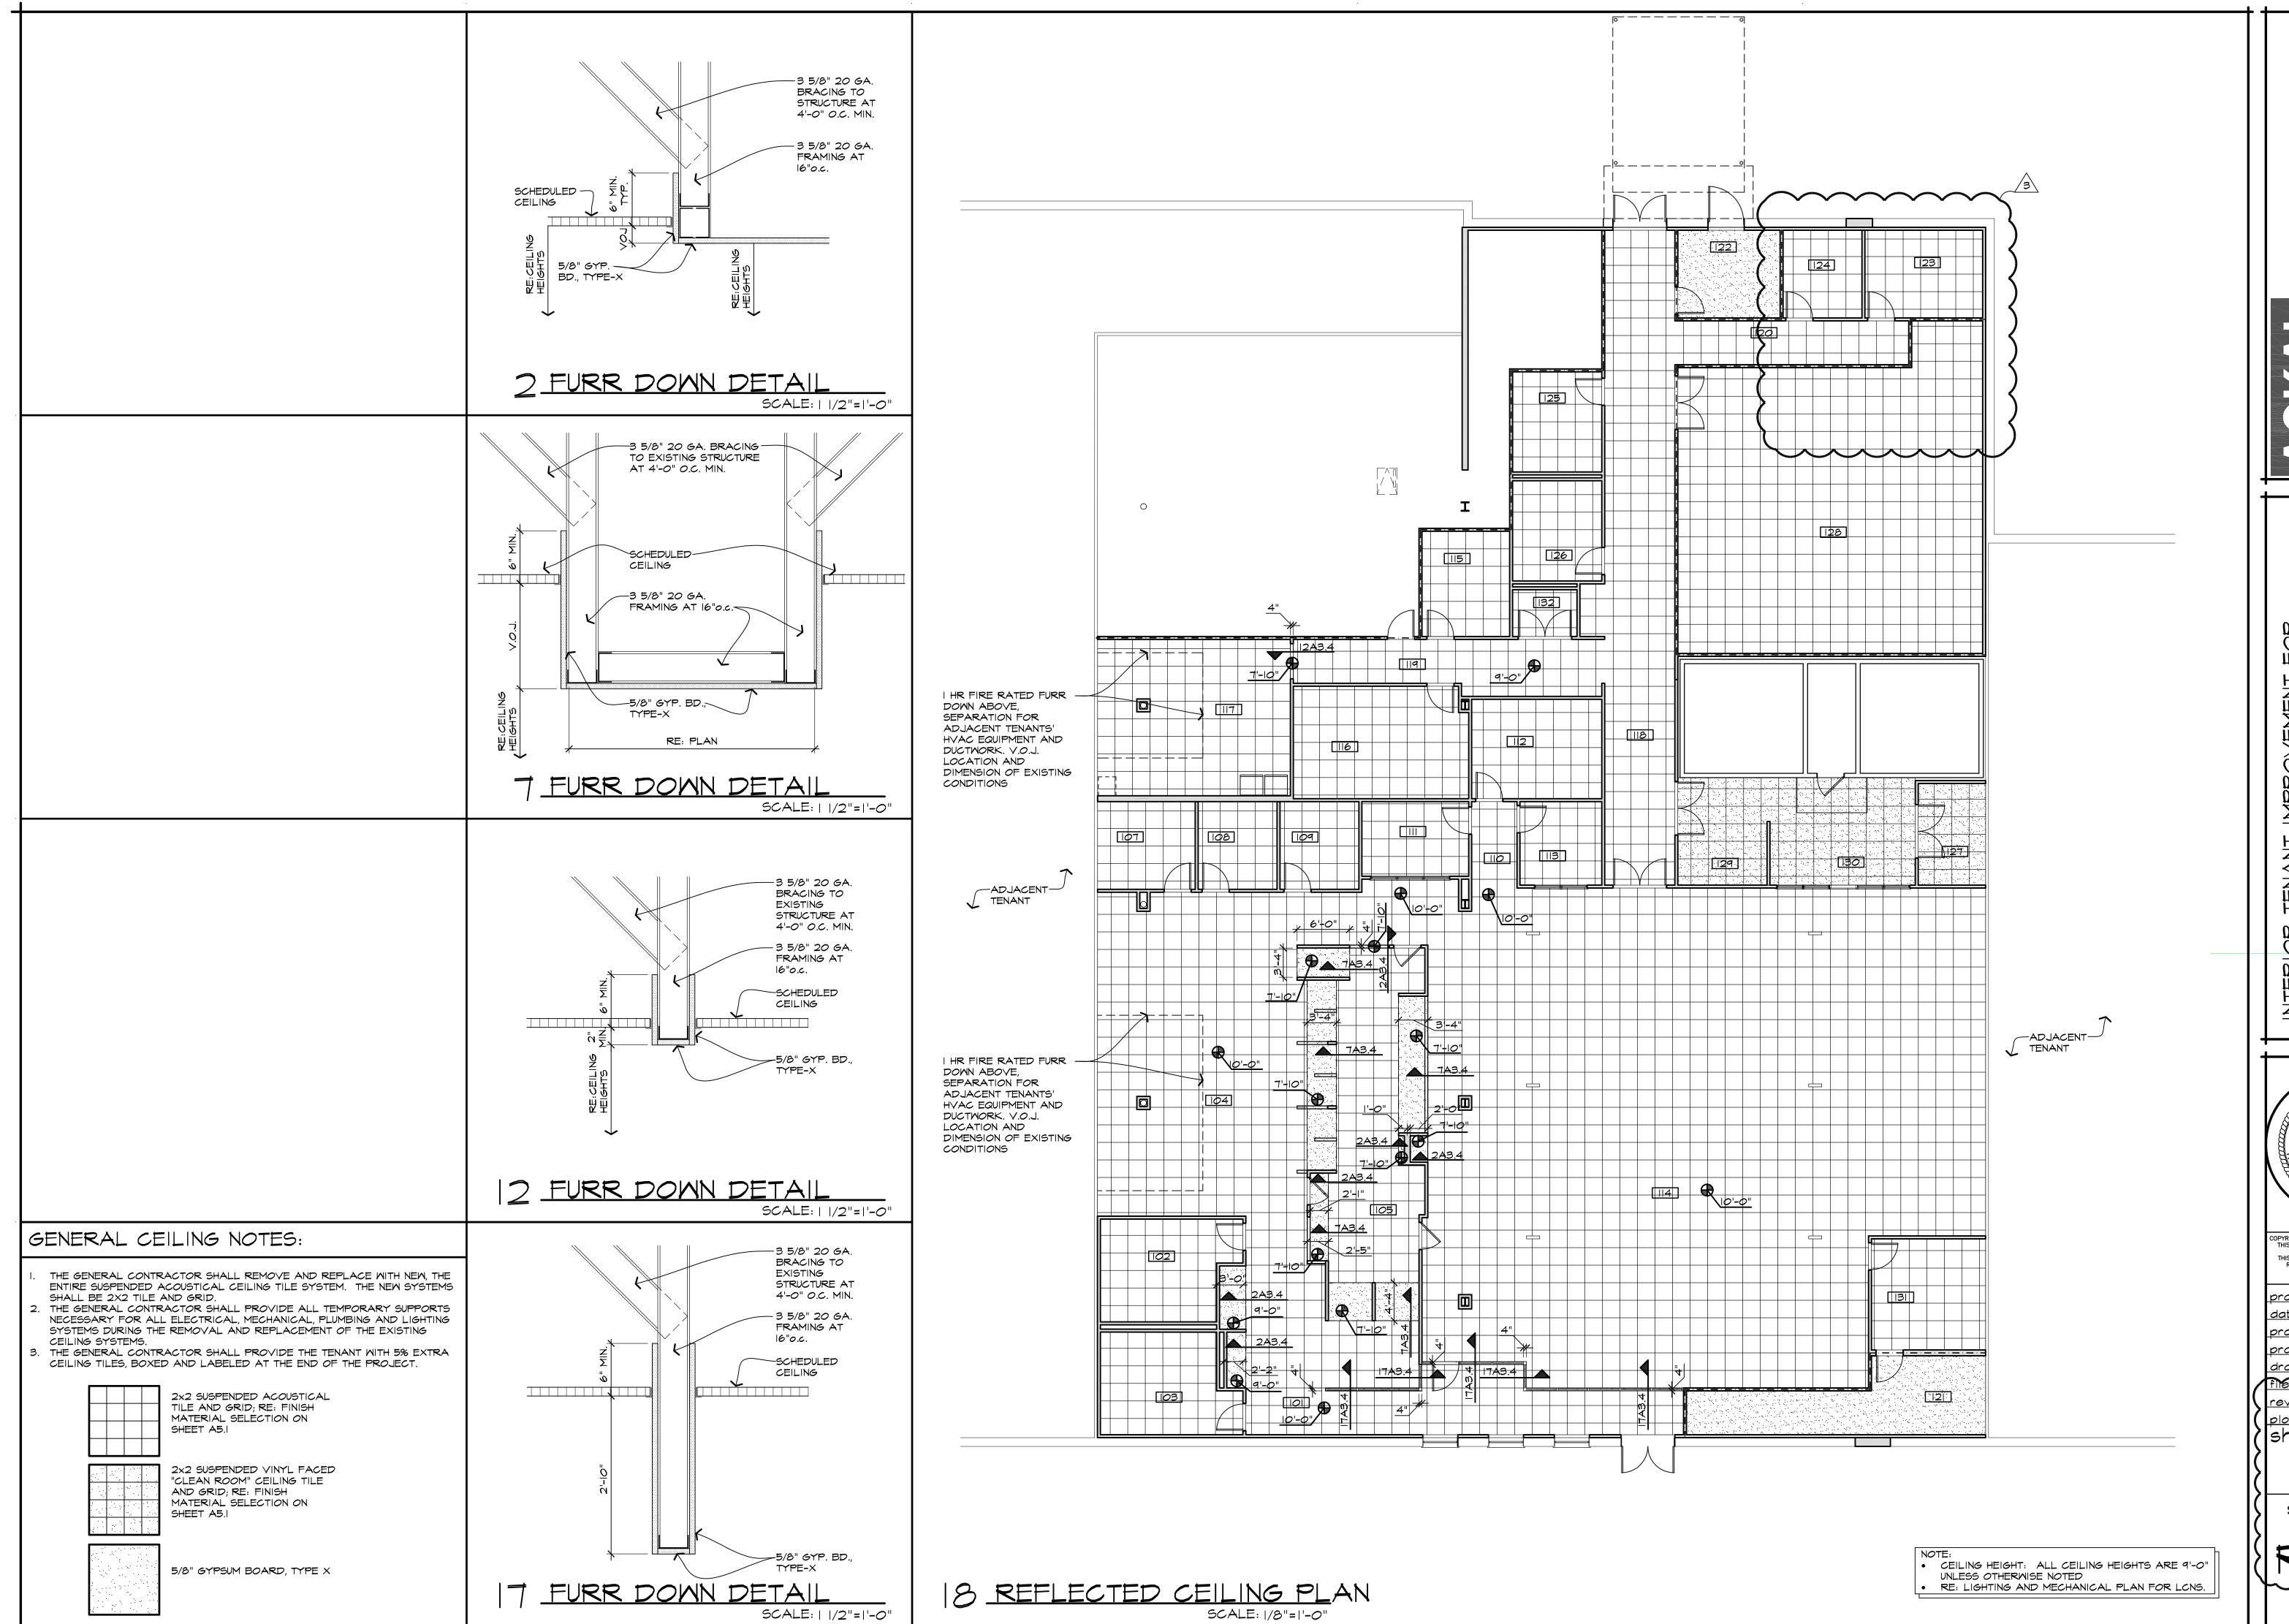

R C H I T E C HAPEL DRIVE - LAFAYETTE, LOUISIANA 70506

988 - 5271 ph. - 337 - 988 - 5272 fax

INITALOR ITNANI IMPROVIMINI FOR:
INMUNOTER DIO OENTERO, ILO
4500 LAKE NORTH ROAD
OFFICE DEPOT PLAZA, SUITE B-5
LAKE NORTH, PALM BEACH COUNTY, FL 38

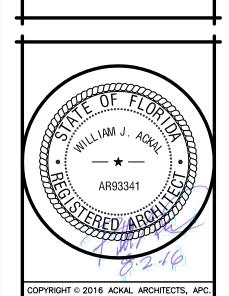

COPYRIGHT © 2016 ACKAL ARCHITECTS, AP
THIS DOCUMENT IS THE PROPERTY OF
ACKAL ARCHITECTS, APC.
THIS DOCUMENT MAY NOT BE COPIED,
REPRODUCED OR USED WITHOUT
WRITTEN CONSENT FROM
ACKAL ARCHITECTS, APC.

proj. no. 16-002

date: 08-02-2016

project architect: B.A

project manager: A.D

drawn by: A.D., J.L., C.T

file name: LAKEMORTH

revised: 3 9-2-16

revised:/3 9-2-16

plot scale: |:|


sheet name:


REFLECTED

sheet no.

CEILING PLAN

RA3.4

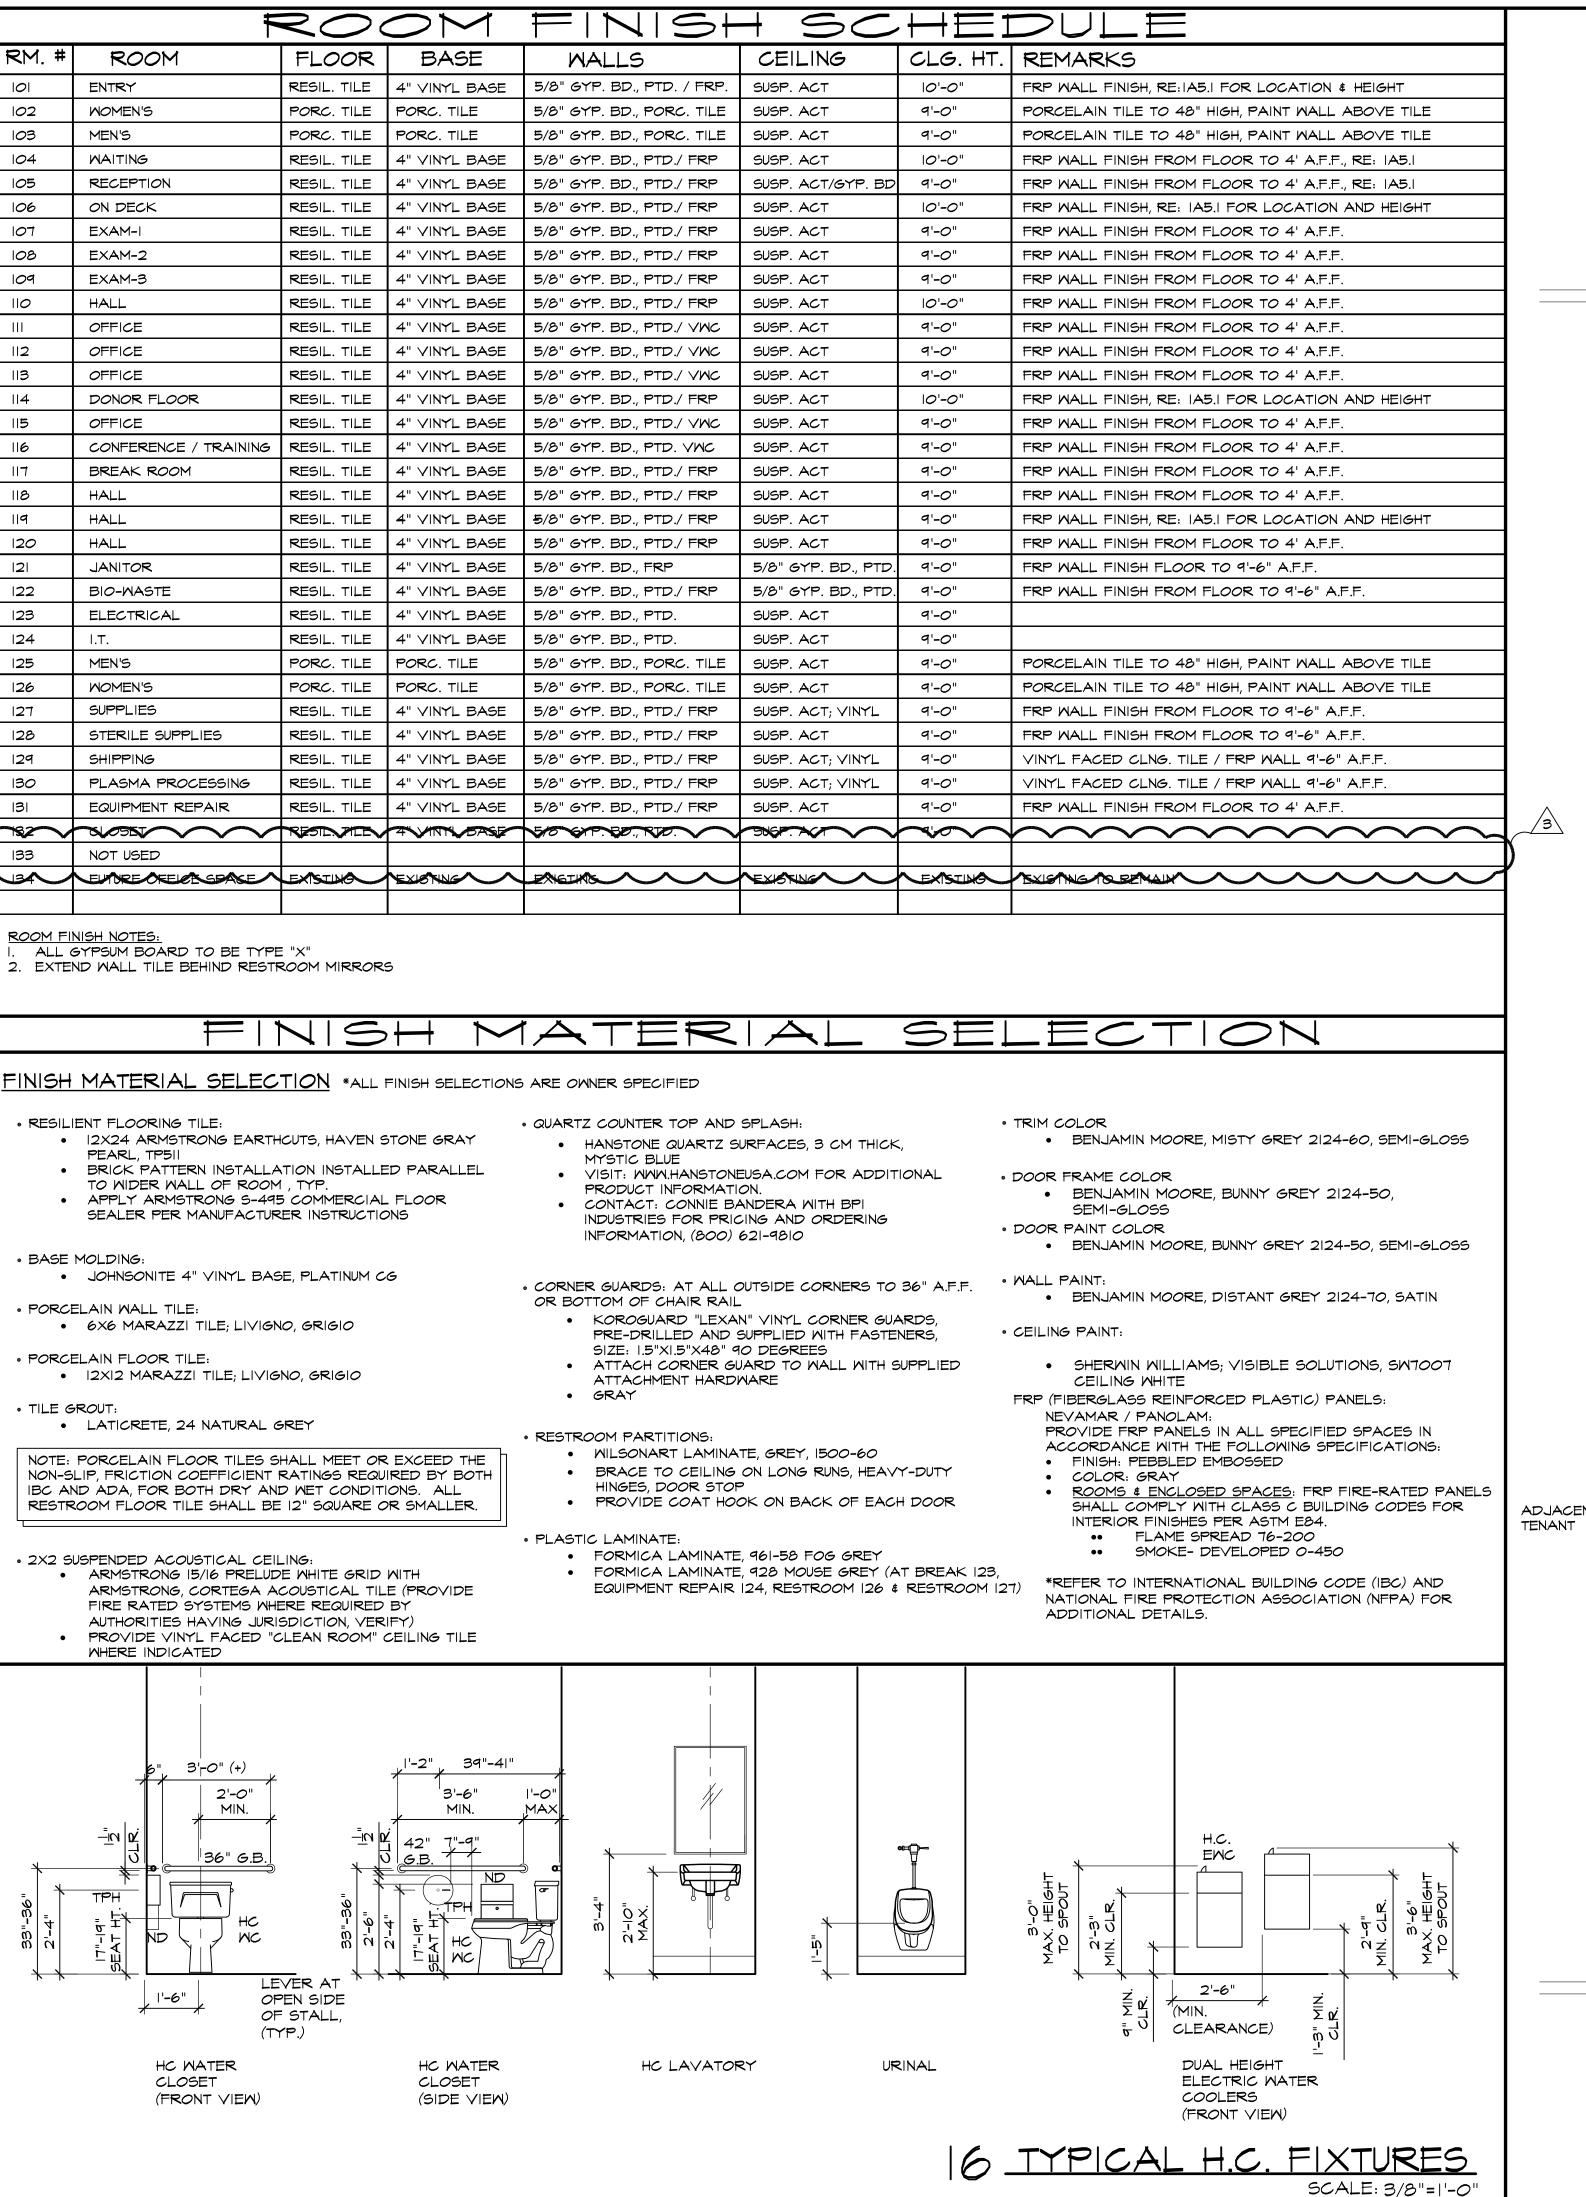

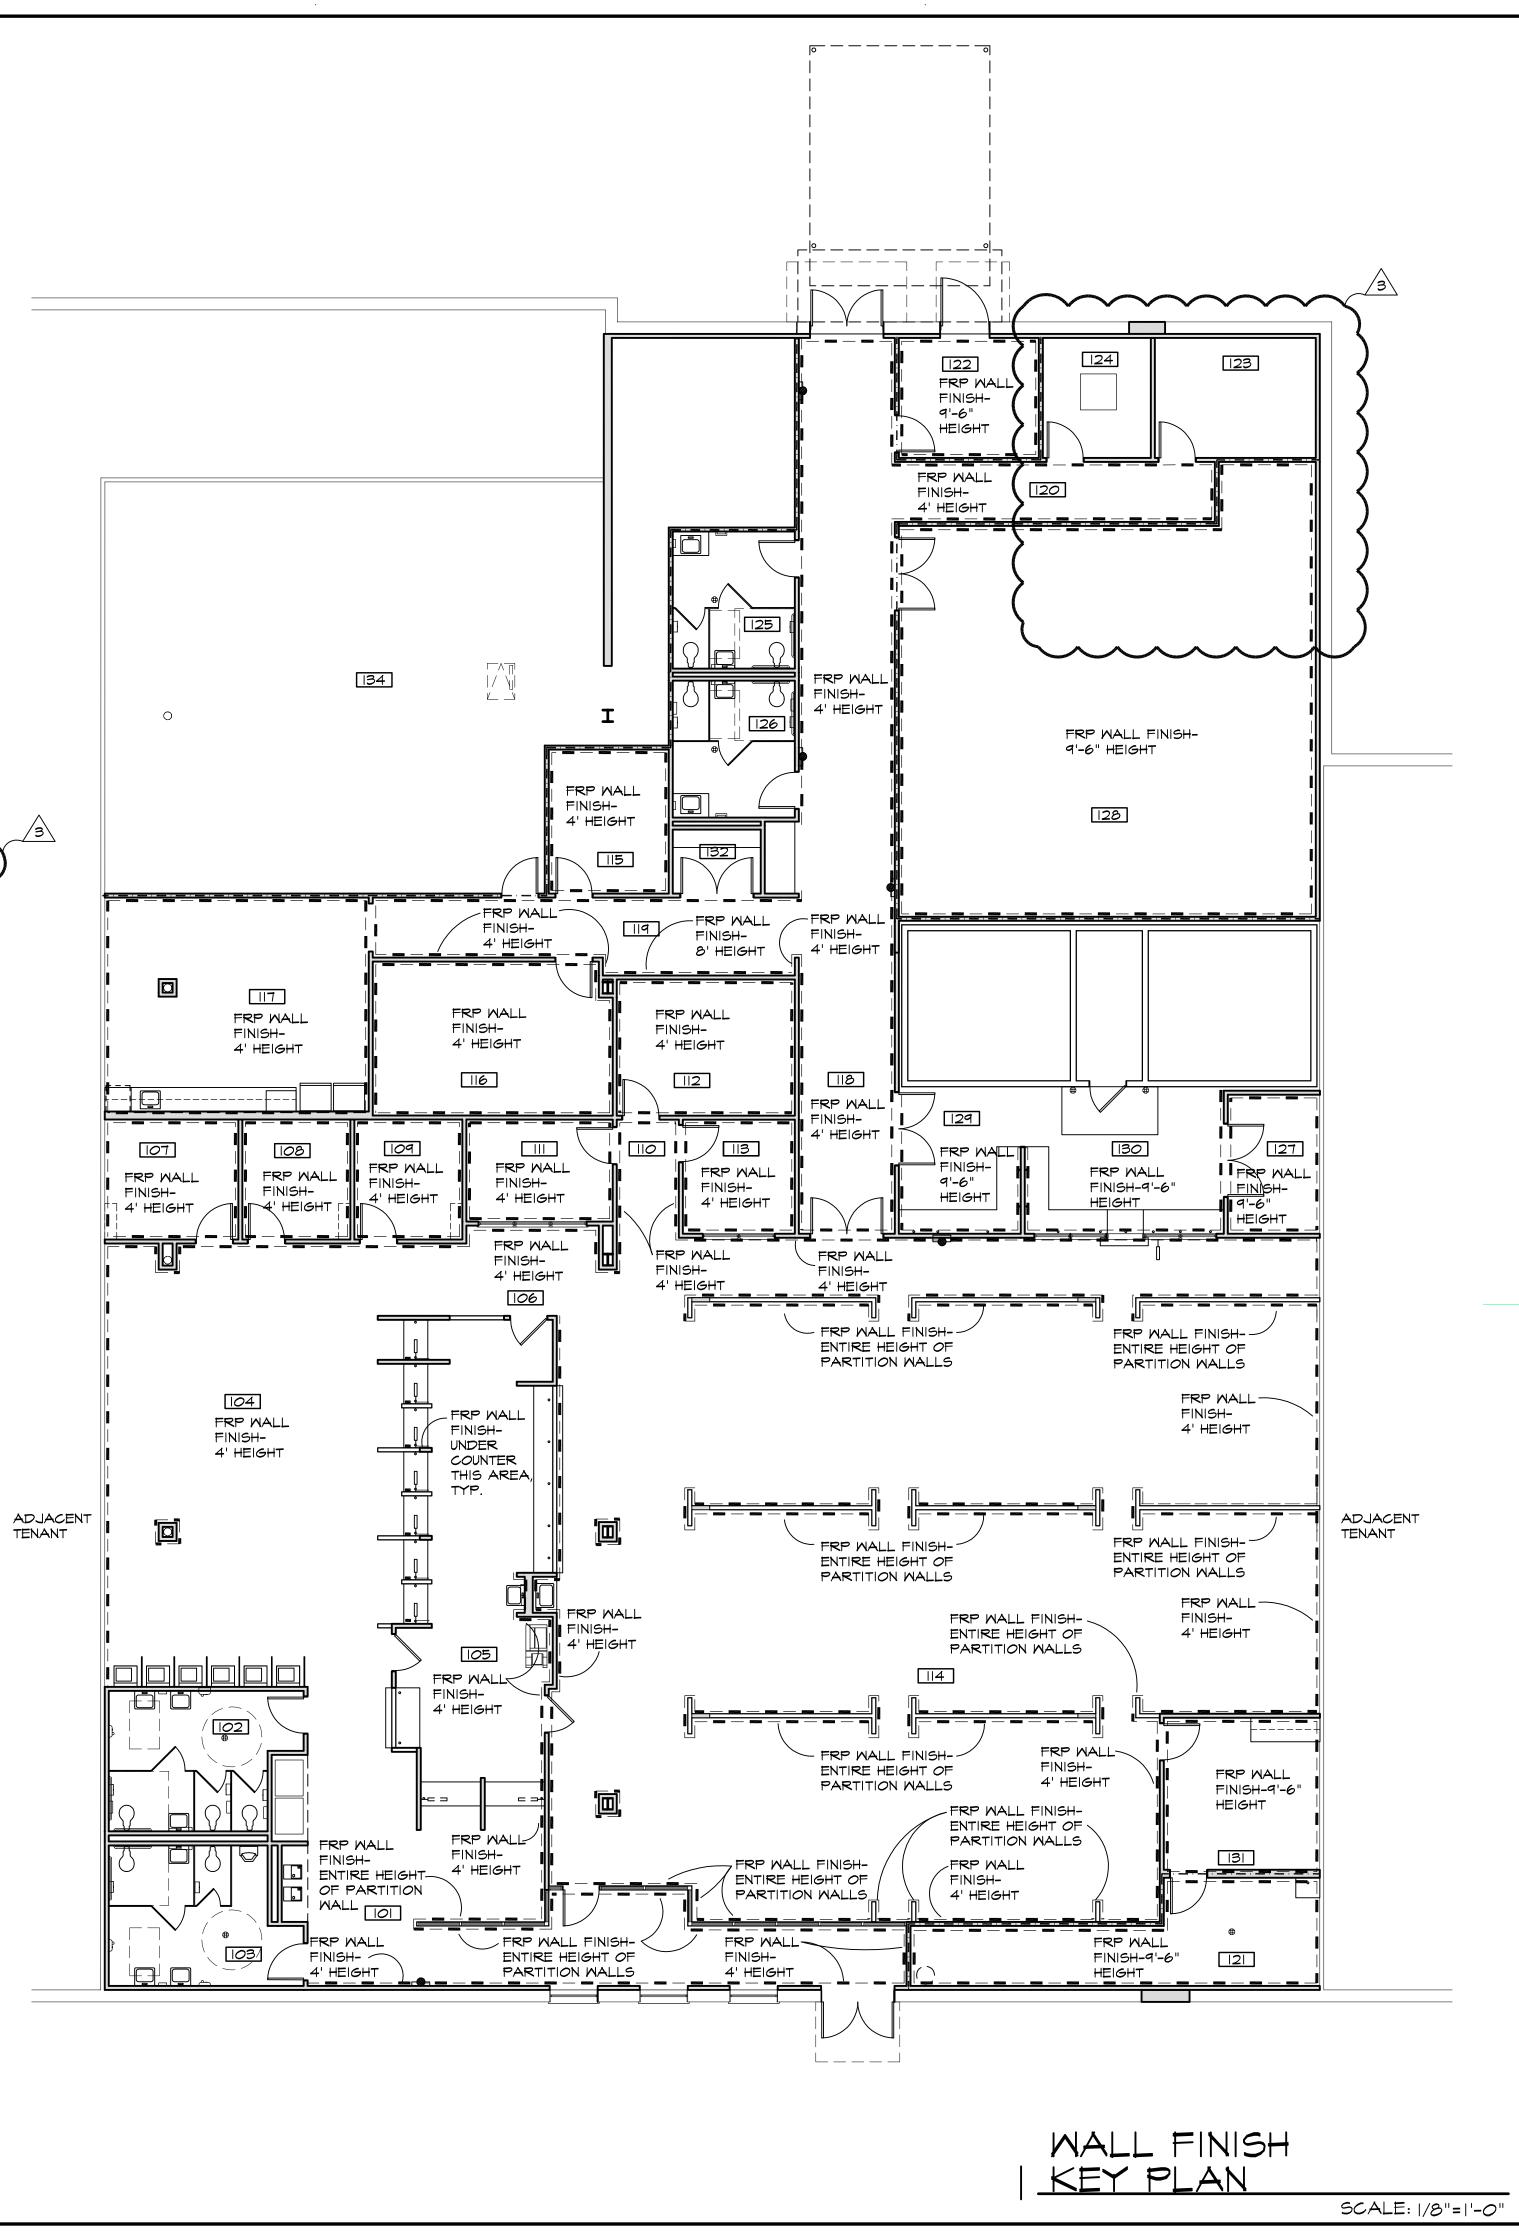

A PROFESSIONAL CORPORAT

A R C HAPELDRIVE - LAFA

INTERIOR TENANT IMPROVEMENT FOR:

IMMUNOTER BIO OENTERO, LLO
4560 LAKE MORTH ROAD

OFFICE DEPOT PLAZA, SUITE B-5

LAKE MORTH PALM BEACH COUNTY FL

COPYRIGHT © 2016 ACKAL ARCHITECTS, APC.

COPYRIGHT © 2016 ACKAL ARCHITECTS, AF
THIS DOCUMENT IS THE PROPERTY OF
ACKAL ARCHITECTS, APC.
THIS DOCUMENT MAY NO! BE COPIED,
REPRODUCED OR USED WITHOUT
WRITTEN CONSENT FROM
ACKAL ARCHITECTS, APC.

Proj. no. 16-002

date: 08-02-2016

proj. no. 16-002

date: 08-02-2016

project architect:B.

project manager: A.:

drawn bu: A.D. J.L. G

project manager: A.I. drawn by: A.D., J.L., C. file name: LAKEMORTH revised: 3 9-2-16

plot scale: 1:1


sheet name:


RM. FINISH SCHED. /

RM. FINISH SCHED. /
FINISH SELECTION /
WALL KEY PLAN

sheet no.

RA5.

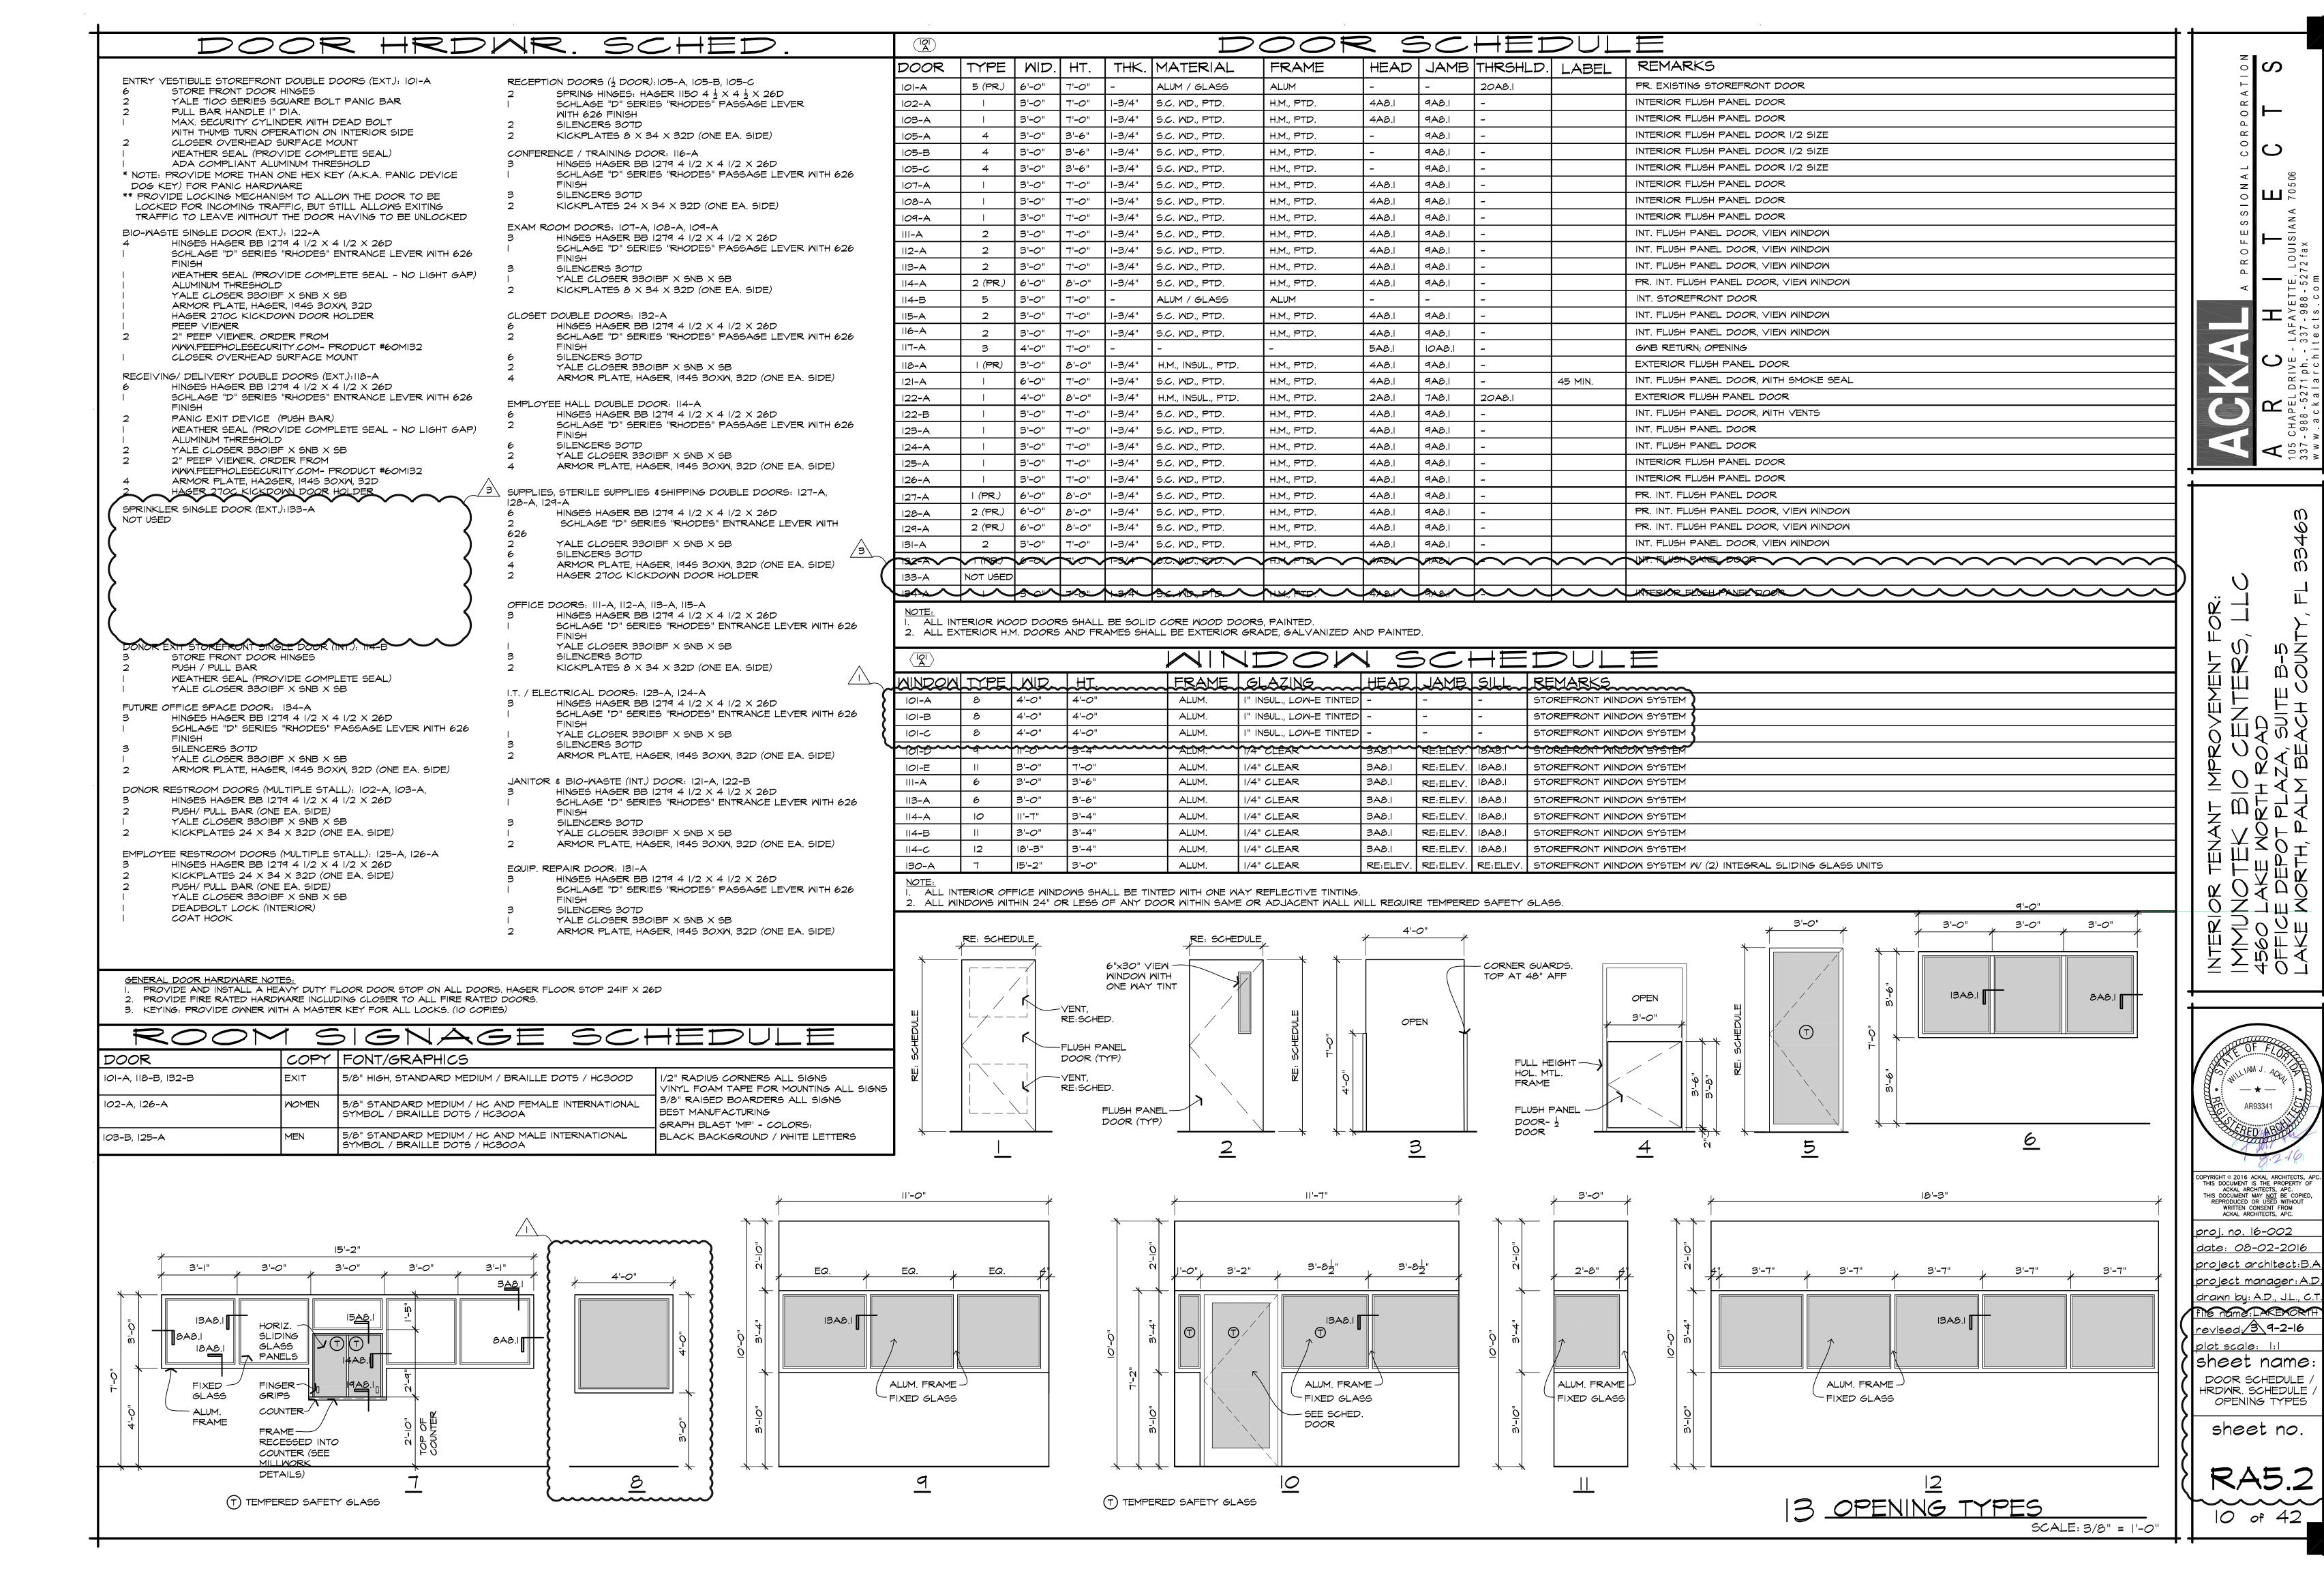

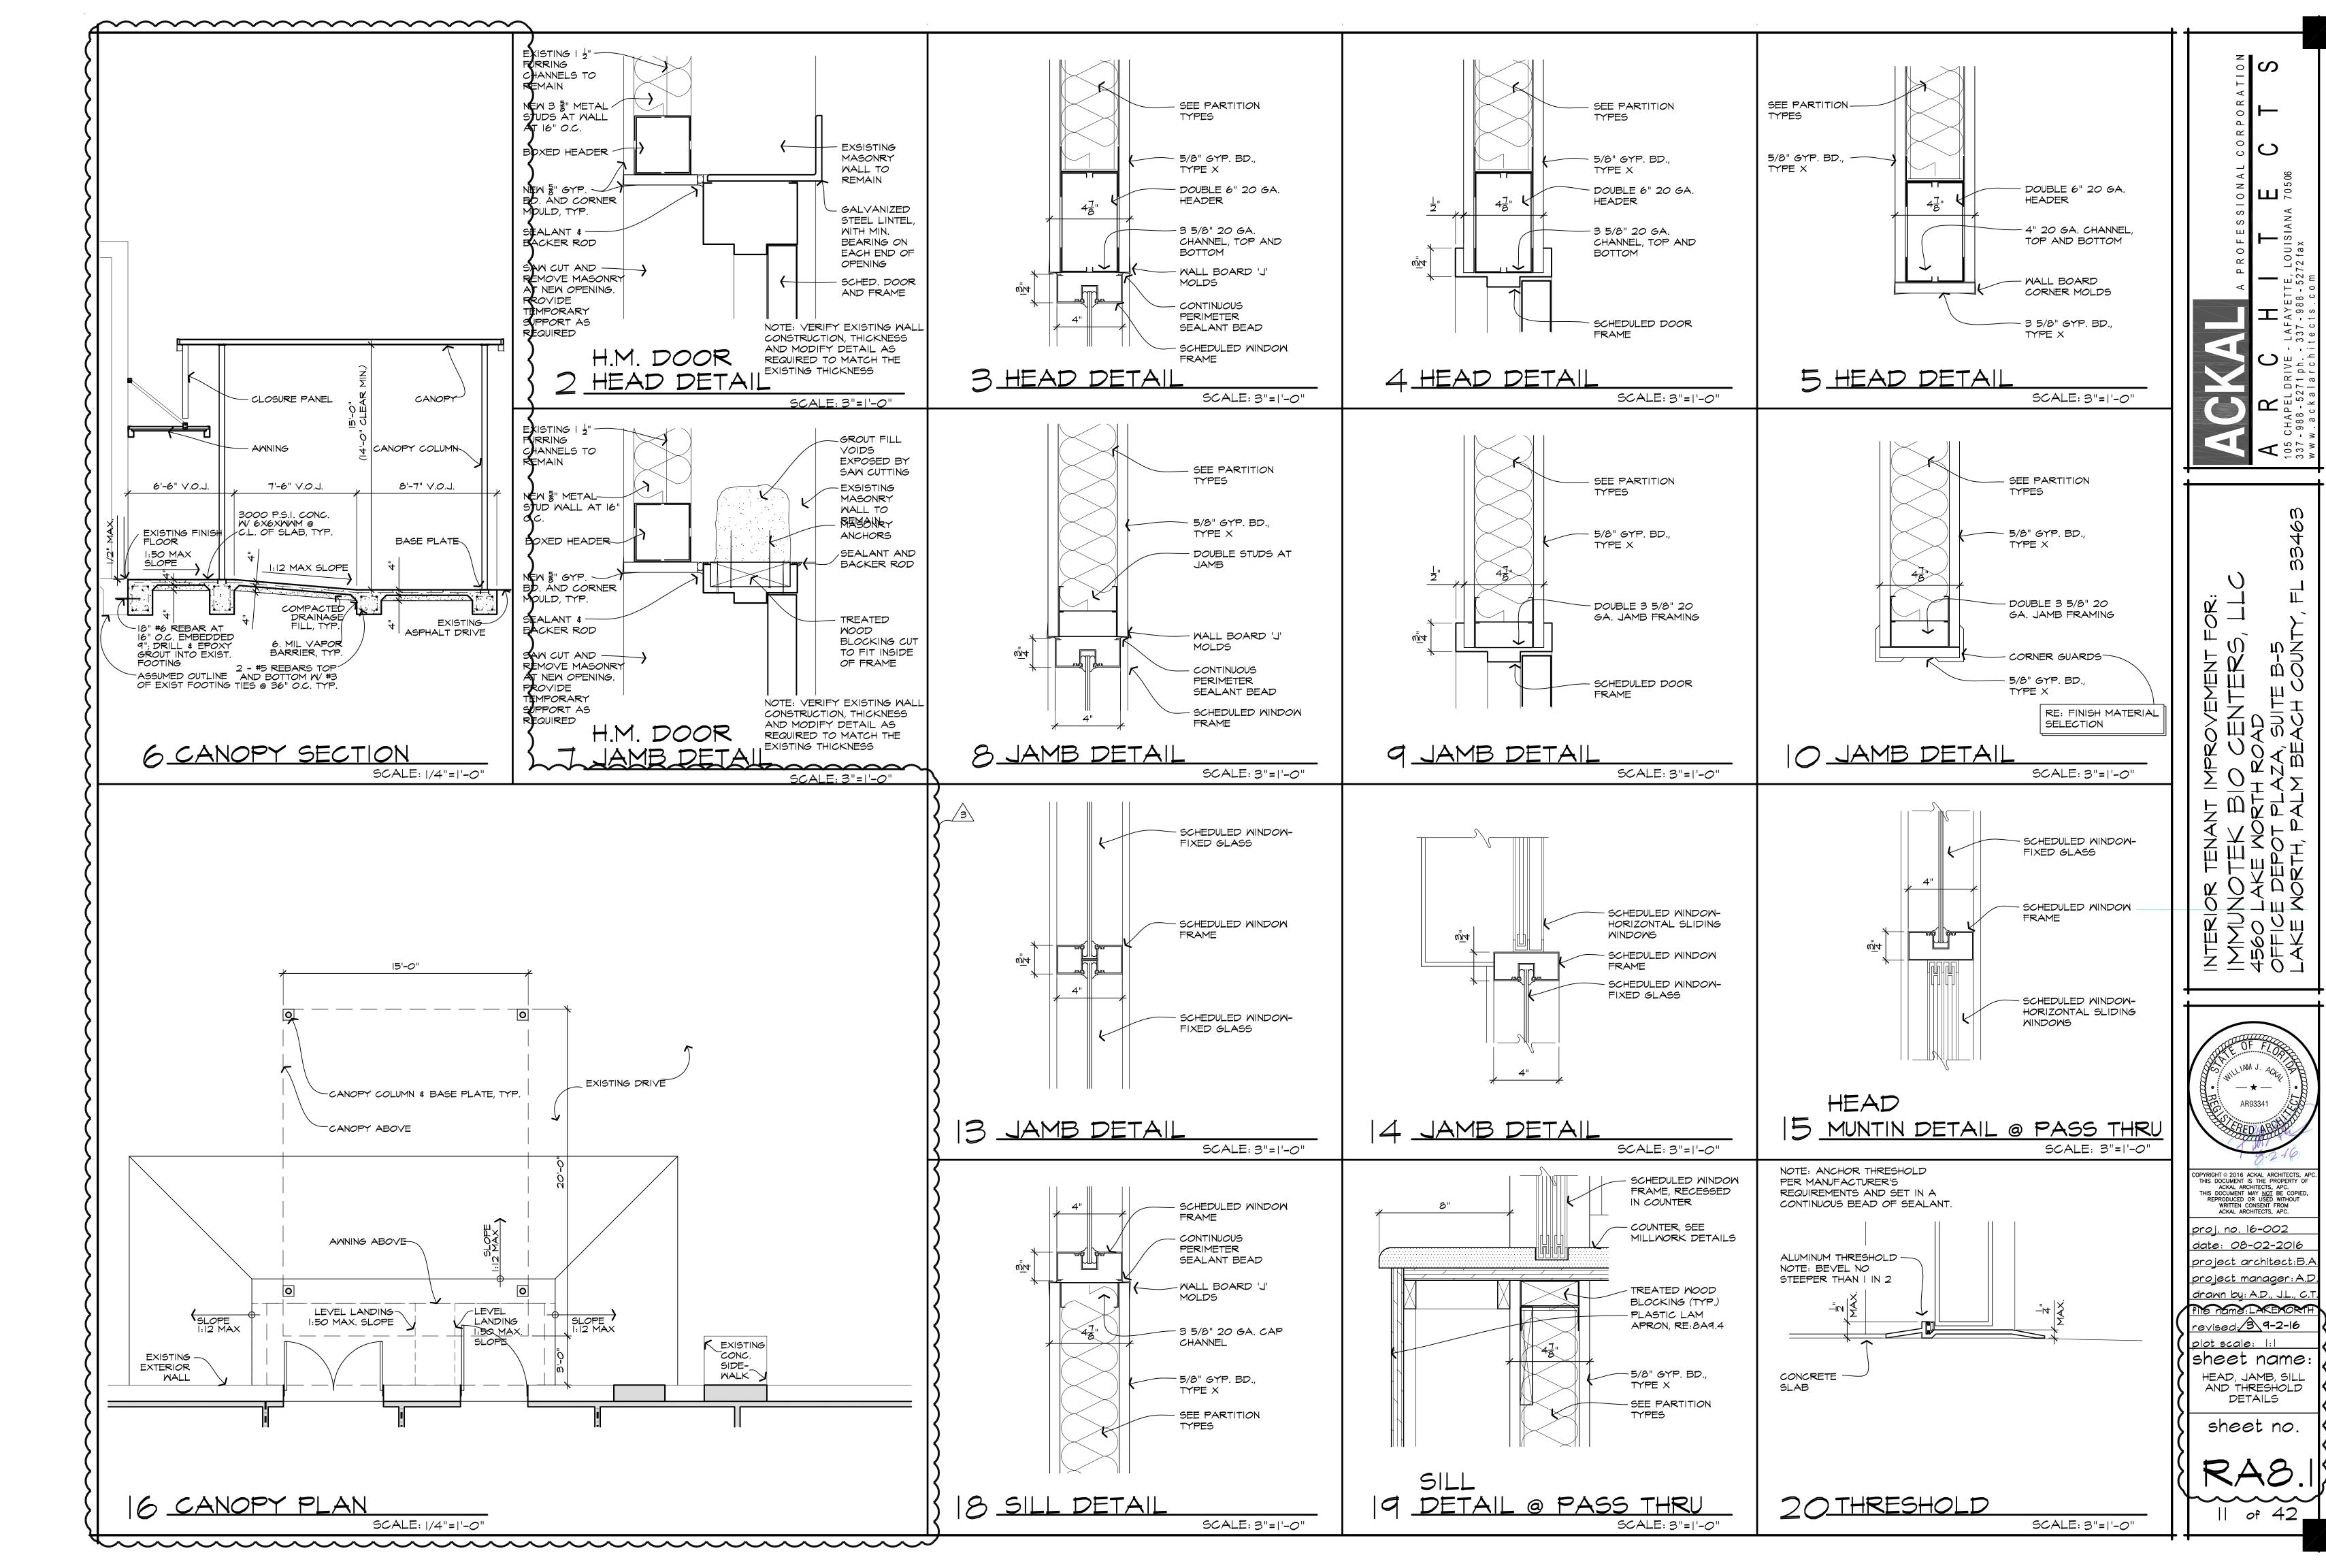

- CODES: ALL ELECTRICAL WORK SHALL BE PERFORMED IN ACCORDANCE WITH ALL ADOPTED APPLICABLE CODES AND ORDINANCES.
- COMPLETE INSTALLATION: PROVIDE ALL LABOR, MATERIALS, EQUIPMENT, TOOLS, ACCESSORIES, ETC., NECESSARY TO ACCOMPLISH A COMPLETE ELECTRICAL SYSTEM IN ACCORDANCE WITH THE DRAWINGS AND SPECIFICATIONS.
- GROUNDING: GROUND ALL EQUIPMENT AND SYSTEM NEUTRAL IN ACCORDANCE WITH ARTICLE 250 OF THE NEC. PROVIDE CODE SIZED EQUIPMENT GROUNDING CONDUCTOR IN ALL FEEDERS AND BRANCH CIRCUIT RACEWAYS, WHERE ISOLATED GROUNDS ARE INDICATED, PROVIDE INSULATED CONDUCTOR.
- CIRCUITING: ALL WIRING SHALL BE IN CONDUIT, CONCEALED EXCEPT WHERE NOTED. EMT WITH DIE CAST SET SCREW FITTINGS MAY BE USED IN DRY, PROTECTED INTERIOR LOCATIONS. PVC SCHEDULE 40 SHALL BE USED BELOW GRADE AT MINIMUM-24". WRAPPED RIGID ELBOWS AND RISERS SHALL BE USED FOR ALL THROUGH-GRADE TRANSITIONS AND STUB-UPS. RGS OR IMC CONDUIT WITH THREADED FITTINGS SHALL BE USED IN ALL LOCATIONS WHERE EXPOSED TO THE ELEMENTS OR SUBJECT TO PHYSICAL DAMAGE. METAL-CLAD CABLE (TYPE MC) MAY BE USED WHERE ALLOWED BY CODE AND LOCAL AUTHORITIES HAVING JURISDICTION (ALL HOMERUNS SHALL BE IN CONDUIT) AND INSTALLED PER NEC ARTICLE 330. TYPE ENT RACEWAY IS NOT ALLOWED. CONNECT RECESSED AND SUSPENDED LIGHT FIXTURES, MOTORIZED AND VIBRATING EQUIPMENT WITH STEEL FLEX. ALL CONDUIT SHALL HAVE PULL CORD IF OTHER WISE EMPTY.
- WIRING: WIRE SHALL BE COPPER UNLESS OTHERWISE NOTED, STRANDED IN SIZES #8 AWG AND LARGER. WHERE ALUMINUM IS INDICATED, WIRE SHALL BE COMPACTED-STRAND TYPE WITH JOINT COMPOUND AT TERMINATIONS, INSULATION SHALL BE TYPE THW, THWN OR THHN (XHHW FOR ALUMINUM). ALUMINUM CONDUCTORS SHALL NOT BE USED IN SIZES SMALLER THAN #1/0 (100 A EQUIPMENT FEEDER), AND WHEN USED SHALL BE TERMINATED IN INSULATED COMPRESSION-TYPE CU/AL FITTING ('MAC-ADAPT' OR EQUAL).
- EXISTING CONDITIONS: CONTRACTOR SHALL VISIT THE SITE AND FAMILIARIZE HIMSELF WITH ALL EXISTING AND PROPOSED CONDITIONS WHICH MAY AFFECT THE COURSE OF HIS WORK. CONTRACTOR SHALL REPORT ALL DISCREPANCIES AND UNACCEPTABLE CONDITIONS TO ENGINEER PRIOR TO BID. 22. ELECTRICALLY-OPERATED EQUIPMENT-FEEDERS AND OVERCURRENT DEVICES COORDINATION: NO EXTRAS WILL BE ALLOWED FOR FAILURE TO COMPLY WITH THIS REQUIREMENT.
- PERMITS: OBTAIN AND PAY FOR ALL BUILDING AND WORKING PERMITS AND INSPECTION FEES REQUIRED FOR THIS PROJECT.
- UTILITY SERVICES: PROVIDE POWER AND COMMUNICATIONS SYSTEM SERVICES IN ACCORDANCE WITH THE REQUIREMENTS OF THE SERVING UTILITIES. PROVIDE EXCAVATION, RACEWAY, STRUCTURES, GROUNDING, ETC. AS DIRECTED. POWER SERVICES AND DISTRIBUTION SYSTEM A.I.C. RATING SHALL EXCEED MAXIMUM AVAILABLE FAULT CURRENT THROUGH UTILITY SERVICE TRANSFORMER. CONTACT SERVING UTILITIES AND OBTAIN THEIR REQUIREMENTS PRIOR TO BID. (UTILITY SERVICE AND LINE EXTENSION CHARGES PAID BY OTHERS).
- Ø. <u>TEMPORARY CONSTRUCTION POWER:</u> PROVIDE TEMPORARY ELECTRICAL POWER DISTRIBUTION AND LIGHTING AS REQUIRED FOR ALL TRADES THAT REQUIRE SERVICE DURING THE COURSE OF THIS PROJECT IN COMPLIANCE WITH ALL NEC AND OSHA REQUIREMENTS. (ENERGY COSTS BY OTHERS.)
- FIRE STOPPING: ALL PENETRATED FIRE RATED SURFACES SHALL BE FIRE SEALED WITH APPROVED U.L. LISTED SEALANTS AS LISTED WITHIN ARCHITECTURAL SPECIFICATIONS. DO NOT EXCEED MAXIMUM ALLOWABLE SURFACE PENETRATIONS DEPENDENT ON RATING OF SURFACES. REFER TO ARCHITECTURAL DRAWINGS FOR DETERMINATION OF PENETRATION LOCATIONS THROUGH FIRE RATED ASSEMBLIES.
- FUSES AND CIRCUIT BREAKERS: FUSES AND CIRCUIT BREAKERS SHALL BE SIZED PER ACTUAL RESPECTIVE APPLICATION (i.e., MOTOR CIRCUIT PROTECTOR, GROUND FAULT CIRCUIT INTERRUPTER, ARC FAULT CIRCUIT INTERRUPTER, ETC.). FUSES SHALL BE DUAL ELEMENT, CURRENT-LIMITING, AND SHALL BE INTERCHANGEABLE BETWEEN FRAME SIZES WITH STANDARD FACTORY FUSE REDUCERS. PROVIDE LOCKABLE SPARE FUSE CABINET WITH THREE (3) SPARE FUSES OF EACH SIZE USED.
- . <u>EQUIPMENT STANDARDS:</u> ALL MATERIALS AND EQUIPMENT SHALL BE NEW AND OF THE HIGHEST QUALITY AVAILABLE ("SPECIFICATION GRADE"). LIGHTING FIXTURES SHALL HAVE ELECTRONIC BALLASTS AND ACRYLIC LENSES. SERVICE EQUIPMENT SHALL BE FACTORY ASSEMBLED COMMERCIAL GRADE, CONFIGURED PER SERVING UTILITY STANDARDS. PANELBOARDS SHALL HAVE BOLT-ON CIRCUIT BREAKERS. WIRING DEVICES SHALL BE SPECIFICATION GRADE WITH NYLON PLATES, IVORY UNLESS OTHERWISE NOTED. RAISED STEEL BOX COVERS MAY BE USED IN UTILITY
- GUARANTEE: THE COMPLETE ELECTRICAL SYSTEM, AND ALL PORTIONS THERE OF, SHALL BE GUARANTEED TO BE FREE FROM DEFECTS IN WORKMANSHIP AND MATERIALS FOR A PERIOD OF ONE YEAR FROM DATE OF FINAL ACCEPTANCE. PROMPTLY REMEDY SUCH DEFECTS AND ANY SUBSEQUENT DAMAGE CAUSED BY THE DEFECTS OR REPAIR THEREOF AT NO EXPENSE TO THE OWNER. LIGHT BULBS ARE EXEMPT FROM THIS GUARANTEE, BUT SHALL BE NEW AND UNUSED AT TIME OF FINAL ACCEPTANCE.
- 5. <u>SUBMITTALS:</u> SUBMIT EIGHT COPIES OF FACTORY SHOP DRAWINGS FOR ALL LIGHTING FIXTURES, SWITCHGEAR, PANELS, MOTOR CONTROLS, WIRING DEVICES, ETC. PROPOSED FOR THIS PROJECT. PROPOSED SUBSTITUTIONS SHALL BE EQUAL OR SUPERIOR TO SPECIFIED ITEMS IN ALL RESPECTS. DETERMINATION OF EQUALITY RESTS SOLELY WITH ENGINEER.
- . <u>LOCATIONS:</u> INDICATED LOCATIONS OF ALL OUTLETS AND EQUIPMENT ARE SUBJECT TO CHANGE. SHIFT/RELOCATE/RECONFIGURE ANY OUTLET, EQUIPMENT OR CONNECTION POINT UP TO 10' AS DIRECTED BY ENGINEER AT NO ADDED COST.

DESIGN BUILD FIRE ALARM SYSTEM NOTES

IN ADDITION TO SPECIFICATIONS NOTE *28, THE FOLLOWING ITEMS SHALL BE INSTALLED OR

CONTRACTOR MUST TAKE ALL PRECAUTIONS TO PROTECT SPRAYED ON FIREPROOFING.

IØ. THERE SHALL NOT BE ANY CONNECTION TO THE DEPARTMENT OF AVIATION EMCS/LIFE

SAFETY OR SPRINKLER SYSTEMS WITHOUT PRIOR WRITTEN APPROVAL FROM AN

FURTHERMORE, CONTRACTOR SHALL BE RESPONSIBLE FOR THE REPAIR OF THE SAME IF

RELOCATED COMPLETE:

DAMAGED OR REMOVED DURING CONSTRUCTION.

AUTHORIZED DOA REPRESENTATIVE.

- 17. IDENTIFICATION: IDENTIFY ALL EQUIPMENT, SWITCHBOARD CIRCUITS AND ELECTRICALLY CONNECTED EQUIPMENT WITH ENGRAVED NAMEPLATES. NAMEPLATES SHALL BE FASTENED WITH A MINIMUM OF TWO (2) SCREWS. PANEL DIRECTORIES SHALL BE TYPED.
- 18. PANELBOARDS: PANELS SHALL HAVE FLUSH MONO-FLAT TRIM, PIANO HINGED DOORS AND COVER (DOOR-IN-DOOR) WITH LOCKABLE MASTER-KEYED FLUSH CATCHES AND BOLT-ON CIRCUIT BREAKERS, FLUSH-MOUNTED PANELS SHALL HAVE EMPTY CONDUITS STUBBED TO ACCESSIBLE ATTIC SPACE: (1) 1" CONDUIT FOR EACH (4) SPARE/SPACE CIRCUITS.
- 19. TAMPERPROOF: ALL EQUIPMENT AND CIRCUITING ACCESSIBLE BY THE PUBLIC SHALL BE DEMONSTRATED TO BE TAMPERPROOF AND VANDAL RESISTANT. OPENABLE DEVICES AND EQUIPMENT SHALL BE PAD LOCKABLE.
- 20. SUPPORTS AND HANGERS: SUPPORT AND ALIGN ALL RACEWAYS, CABINETS, BOXES, BACK BOXES. FIXTURES, AND EQUIPMENT FROM STRUCTURE. SECURE ALL SUPPORTING METHODS BY MEANS OF TOGGLE BOLTS IN HOLLOW MASONRY, EXPANSION BOLTS IN SOLID MASONRY, CONCRETE PRESET INSERTS OR EXPANSION BOLTS IN CONCRETE, MACHINE SCREWS OR BOLTS IN METAL, AND WOOD SCREWS IN WOOD CONSTRUCTION. ALL SUPPORTING SYSTEMS AND COMPONENTS SHALL BE RATED FOR FIVE (5) TIMES THE ACTUAL LOAD.
- 21. <u>ELECTRIC ROOM CODE COMPLIANCE</u>: DUE TO THE DIAGRAMMATIC NATURE OF THE DESIGN DOCUMENTS (ELECTRICAL, MECHANICAL, PLUMBING, FIRE SPRINKLER, ETC.). IT SHALL BE THIS CONTRACTOR'S RESPONSIBILITY TO COORDINATE WITH ALL OTHER SUBCONTRACTORS AT THE START OF THIS PROJECT TO INFORM AND VERIFY THAT NO FOREIGN SYSTEMS OR EQUIPMENT PASS THROUGH THE DESIGNATED ELECTRIC ROOMS AND THAT A MINIMUM OF 1'-Ø" IS PROVIDED AS CLEAR HEADROOM ALONG ACCESS PATHS TO ALL ELECTRIC ROOMS. ANY REPOUTING OR RELOCATION OF SYSTEMS THAT A SUBCONTRACT OR FEELS WILL COMPROMISE THE INITIAL DESIGN INTENT SHALL BE DESCRIBED IN WRITING AND FORWARDED TO THE DESIGN ENGINEER FOR FURTHER REVIEW. ALL PIPING TO HYAC UNITS THAT COOL ELECTRIC ROOMS SHALL BE LOCATED ABOVE THE ENTRY DOORS WHEN EVER POSSIBLE. THE SPRINKLER PIPING TO PROVIDE PROTECTION FOR THE ELECTRIC ROOM IS PREFERRED TO ENTER THE ROOM ABOVE THE ENTRY DOOR AND RUN DOWN THE AISLE SPACES OF THE ROOM. ALL INSTALLATIONS SHALL BE FULLY COORDINATED AMONG ALL
- FEEDERS AND OVERCURRENT DEVICES (INCLUDING STARTERS, DISCONNECTS, ETC.) HAVE BEEN DESIGNED BASED ON INFORMATION PROVIDED BY THE RESPONSIBLE CONSULTANT AND/OR DESIGNATED SUPPLIER. PRIOR TOROUGH-IN, COORDINATE WITH THE APPROPRIATE TRADE AND/OR INSTALLER TO DETERMINE THAT THE ACTUAL NAMEPLATE ELECTRICAL REQUIREMENTS MATCH THIS DESIGN. ALL COST REDUCTION, VALUE ENGINEERING, SUBSTITUTION PROPOSALS, ETC. CONCERNING ELECTRICALLY POWERED EQUIPMENT AND SYSTEMS WHICH IMPACT THE ELECTRICAL SYSTEMS OF THIS PROJECT SHALL INCLUDE ALL ELECTRICAL COSTS AND/OR CREDITS ASSOCIATED WITH SUCH PROPOSALS AND SHALL BE COORDINATED AMONGST THE GENERAL CONTRACTOR AND THE SEVERAL AFFECTED TRADES PRIOR TO SUBMISSION FOR REVIEW.
- 23. COORDINATION: THIS PROJECT REQUIRES A HIGH LEVEL OF COORDINATION AND COOPERATION WITH OWNER, ARCHITECT, OTHER TRADES, VENDORS, AND SPECIALTY CONTRACTORS. THIS CONTRACTOR SHALL OBTAIN AND STUDY SHOP DRAWINGS OF ALL ELECTRICALLY CONNECTED EQUIPMENT AND SHALL ADJUST POINTS OF CONNECTION, LOCATIONS, AND MOUNTING HEIGHTS AS NECESSARY PRIOR TO ROUGH-IN.
- 24. BIDDING: THE CIVIL, ARCHITECTURAL, MECHANICAL, KITCHEN AND INTERIOR DRAWINGS CONTAIN DETAIL DESCRIPTIONS, CIRCUITING AND CONNECTION REQUIREMENTS WHICH ARE PART OF DIVISION 16 RESPONSIBILITIES. THIS CONTRACTOR SHALL NOT SUBMIT BIDS ON THIS PROJECT BEFORE REVIEWING ALL PROJECT DRAWINGS, SPECIFICATIONS, AND ADDENDA.
- 25. FIRE ALARM: THE CONTRACTOR SHALL PROVIDE A COMPLETE FIRE ALARM SYSTEM IN FULL ACCORDANCE WITH LOCAL, STATE AND ADA REQUIREMENTS. THESE DOCUMENTS DO NOT INDICATE DEVICES, OUTLETS, CONNECTIONS, AND CIRCUITRY NECESSARY FOR A COMPLETE FIRE ALARM SYSTEM. OBTAIN FIRE MARSHAL APPROVED SHOP DRAWINGS PRIOR TO COMMENCEMENT OF ROUGH-IN. PROVIDE COMPLETE SYSTEM TESTING UPON COMPLETION OF INSTALLATION AND PRIOR TO FIELD ACCEPTANCE BY OWNER.
- 26. ADDITIONAL SYSTEMS AND EQUIPMENT CONNECTIONS: IN ADDITION TO EQUIPMENT POWER FEEDERS AND CONNECTIONS INDICATED ON THE ELECTRICAL DRAWINGS, PROVIDE 120Y CONTROL POWER CONNECTIONS TO SMOKE/FIRE DAMPERS, VAV BOXES, TEMPERATURE CONTROL AND FIRE ALARM PANELS, DOOR HOLDING/LATCHING DEVICES, ETC. AS INDICATED IN THE PROJECT DRAWINGS AND SPECIFICATIONS AS WELL AS ALL DESIGN-BUILD SYSTEM DRAWINGS.

<u>ITEM</u>	<u>POWER</u> SOURCE	NO. PER 20A CIRCUIT	PROVIDESMOKE DETECTORS
FIRE/SMOKE DAMPER	EMERGENCY	10	YES
YAY TERMINAL (NOFAN)	NORMAL (VERIFY)	10	NO
TEMPERATURE CONTROL PANEL	EMERGENCY (VERIFY)	1	NO
FIRE ALARM PANEL	EMERGENCY	1	NO
DOOR HOLDING/LATCHING DEVICE	S EMERGENCY	10	NO

27. COMMUNICATION SYSTEMS: THE ELECTRICAL CONTRACTOR SHALL PROVIDE OUTLETS AND RACEWAYS FOR COMMUNICATION SYSTEMS AS INDICATED HERE IN, INCLUDING TELEPHONE, DATA AND POINT-OF-SALE. CABLING AND DEVICES SHALL BE INSTALLED AND TERMINATED BY OTHERS. OTHER COMMUNICATION SYSTEMS (i.e., SOUND, SECURITY, AUDIO/VISUAL, CCTV, MATY, ETC.) SHALL BE DESIGNED AND INSTALLED BY OTHERS.

* * | * * | *

10 6

28. ALL DEVICES INSTALLED WITHIN PATIENT CARE AREAS SHALL COMPLY WITH NEC ARTICLE 517. PATIENT CARE AREAS ARE TO INCLUDE DONOR FLOOR, EAM ROOMS, SCREENING ROOMS, ETC.

DRAWING INDEX

. ALL MONITORING, DEVICES, WIRING, TESTING, ETC., FOR ALL DUCT DETECTORS.			压 22-2 <i>©</i>	NDUN 8-8	
2. LIFE SAFETY DEVICES SUCH AS FIRE ALARM PULL STATIONS, HORN STROBES, ETC. 3. ALL DETECTOR POWER SHALL BE HARDWIRED INTO HOUSE PANEL.			T 155UE 08-02	ADDENDU DATE: 09-	
4. ALL DETECTOR MONITORING SHALL BE ON HOUSE MONITORING PANEL.	SHEET		│☆世│	\@	
DETECTORS SHALL BE "SMOKE" TESTED FOR BUILDING INSPECTIONS PER LOCAL	NUMBER	SHEET TITLE	<u>D</u> D		<u> </u>
JURISDICTION HAVING AUTHORITY OR HVAC UNITS SHALL BE HOT WIRED FOR DETECTOR INSPECTIONS. INCLUDE ALL ASSOCIATED COSTS.	EØ.Ø	SYMBOL LIST AND GENERAL NOTES			
6. INCLUDE ALL CONDUIT, WIRE, CONNECTIONS, ETC., TO FIRE RISER ALARM PANEL.	EØ.1	SINGLE LINE DIAGRAM			
T HILLEDE ADDITIONED TO THE ALL CONDUIT HIDE CONNECTIONS ETC. TO PICK VALVES	EØ .2	PANEL SCHEDULES			
1. WHERE APPLICABLE, INCLUDE ALL CONDUIT, WIRE, CONNECTIONS, ETC., TO 'PIV' VALVES. COORDINATE WITH SITE UTILITIES CONTRACTOR FOR COMPLETE SCOPE OF THIS WORK.	EØ.3	LIGHTING FIXTURE SCHEDULE			
3. WHERE APPLICABLE, INCLUDE ALL CONDUIT, WIRE, CONNECTIONS, ETC., TO 'DCDA' ALARM	EØ.4	LIGHTING COMPLIANCE CERTIFICATE			
POINTS, COORDINATE WITH SITE UTILITIES CONTRACTOR FOR COMPLETE SCOPE OF THIS WORK.	ED2.Ø	ELECTRICAL DEMOLITION PLAN			
CONTRACTOR MILET TAKE ALL RECALITIONS TO REPOTECT SERVAYED ON EIRERPROPEING	E2.Ø	POWER PLAN	•	•	

SIGNAL PLAN

TOTAL

LIGHTING PLAN

ELECTRICAL ROOF PLAN

ELECTRICAL SYMBOL LIST

	FLUORESCENT FIXTURE - RECESSED, LAY-IN		SWITCHGEAR
0	FLUORESCENT FIXTURE - RECESSED, FLANGED		PANELBOARD - SURFACE MOUNTED
0	FLUORESCENT FIXTURE - SURFACE	_	PANELBOARD - FLUSH MOUNTED
• •	FLUORESCENT FIXTURE - SUSPENDED		EXISTING / RELOCATED PANELBOARD - SURFACE MOUN
$\vdash \!$	FLUORESCENT FIXTURE - OPEN STRIP WITH WIRE GUARD	_	EXISTING / RELOCATED PANELBOARD - FLUSH MOUNTED
	FLUORESCENT FIXTURE - WALL MOUNTED	_	TRANSFORMER
0	INCANDESCENT, H.I.D. OR MINI-FLUORESCENT - SURFACE OR RECESSED, PER FIXTURE SCHEDULE	₿	ENCLOSED CIRCUIT BREAKER
О	INCANDESCENT, H.I.D. OR MINI-FLUORESCENT - WALL BRACKET		FIRE ALARM EQUIPMENT
0	INCANDESCENT, H.I.D. OR MINI-FLUORESCENT - WALL	F6D	COMBINATION FIRE/SMOKE DAMPER SMOKE DAMPER
_	WASH	(\$ €)	SHUNT TRIP STATION
©	LOW VOLTAGE INCANDESCENT FIXTURE	⊙ ₁	CONTROL STATION AT +48" TO TOP UON (PER ADA)
0	CHANDELIER (PROVIDE 5X STRUCTURAL BACKING)		RELAY
	FAN (PROVIDE 5X STRUCTURAL BACKING) SPOTLIGHT - J-BOX OR TRACK MOUNTED - TRACK LENGTH	$lue{\square}$	CONTACTOR WITH INTEGRAL HOA SELECTOR
⊙ <u> Α</u> Α	AS INDICATED	\boxtimes	MAGNETIC STARTER, SIZE I UON
_	STEP LIGHT - SURFACE OR RECESSED, PER FIXTURE SCHEDULE	타마	DISCONNECT SWITCH: 30/3 UON
×	BOLLARD	⊠H	(F=FUSIBLE (FPEN), N=NONFUSED) COMBINATION STARTER & DISCONNECT: SIZE I UON
O⊸ □□	POLE OR POST - ARM OR TOP MOUNTED CUT-OFF LUMINAIRE	∠ V F D	VARIABLE FREQUENCY DRIVE
lacktriangle	TWIN-LAMP BATTERY PACK - UNSWITCHED, WALL MOUNTED (LOCATE 12" BELOW CEILING U.O.N.)	ď	SINGLE-PHASE MOTOR CONTROL ASSEMBLY:
Þ ⊟ 4	TWIN-LAMP BATTERY PACK - UNSWITCHED, CEILING MOUNTED, FLUSH OR SURFACE PER FIXTURE SCHEDULE	— ⊠	HP-RATED SWITCH AND POWER RELAY-20/1 (U.O.N.)
፟ ❖	EXIT LIGHT - FACES AND ARROWS AS INDICATED,	⊠ ⊙	PULLBOX - SIZE AND LOCATION AS REQUIRED JUNCTION BOX - SIZE PER NEC REQUIREMENTS
4-4	UNIVERSAL MOUNTING, UNSWITCHED	/AC\	MECHANICAL EQUIPMENT DESIGNATION
	EXIT LIGHT - COMBINATION SINGLE FACE. ARROWS AS INDICATED WITH TWIN LAMP BATTERY PACK, UNIVERSAL MOUNTING, UNSWITCHED.		TIESTANGE EGGINEN PLOIGNATION
	EXIT LIGHT - LOW LEVEL: 6" - 8" AFF. TO BOTTOM, 4" MAX. OFF DOOR FRAME	⟨ M) ∕	MOTOR OUTLET
— LY —	LOW YOLTAGE ——LED—— LED	FI 12Ø 3	LIGHTING FIXTURE DESIGNATION: TYPE FI, 120 WATTS QUANTITY = 3
<u> и</u>	NEON		KVA (.A) C = CONNECTED LOAD EQUIPMENT LOAD
ETC.	FIXTURE, EQUIPMENT ON EMERGENCY		KVA (.A) D = DEMAND LOAD SUMMARY (EXPRE KVA (.A) S = STANDBY LOAD IN KVA AND AMPS
5 [×] ,5³, 5	SWITCHES AT +48" TO TOP UON (PER ADA) SWITCH - SINGLE POLE S^2 SWITCH - DOUBLE POLE	$\langle 1 \rangle$	SHEET NOTE DESIGNATION
S^3	SWITCH - SINGLE POLE 5 SWITCH - DOUBLE POLE SWITCH - THREE WAY 5 ⁴ SWITCH - FOUR WAY	42	FEEDER DESIGNATION (SEE FEEDER SCHEDULE)
M	SWITCH - OCCUPANCY TYPE M SWITCH - OCCUPANCY TYPE,		CIRCUITING IN WALL OR ABOVE CEILING
S×	CEILING MOUNTED SWITCH - EMERGENCY		CIRCUITING IN FLOOR OR BELOW GRADE
SP	SWITCH - PILOT TOGGLE (CONFIRM LIGHTED POSITION)	- † -	TICS = NO. OF #12 WIRES IF MORE THAN TWO:
SK	SWITCH - KEYED OPERATED	A-1,3,5— HH	HOMERUN: (4) #12, 3/4"C. TO PANEL A - CIR. 1,3,5
D	SWITCH - SLIDER TYPE ELECTRONIC DIMMER (WATTAGE RATING AS REQUIRED)		AMOD TINO-BUTS
SMC	SWITCH - MOMENTARY CONTACT: SPDT CENTER OFF UON	ľ	I COPPER GROUND ————————————————————————————————————
SM	MANUAL MOTOR STARTER - POLES	<u> </u>	MOISTURE SEAL-OFF
	AND HEATERS AS REQUIRED	3Ø/3	30 AMP / 3 POLE (REPRESENTATIVE)
PE)	PHOTOELECTRIC SWITCH - 1500 VA UON SIGNAGE OUTLET CONNECTION	AL	ALUMINUM
₩ ▼∇	DEVICES AT +18" TO CENTER LINE UON (PER ADA)	AFF	ABOVE FINISHED FLOOR
₩¥V	DEVICES MOUNTED IN MULTIPLE UNDER COMMON COVER	AFG AIC	ABOVE FINISHED GRADE AMP INTERRUPTING CURRENT
ш	MAXIMUM HEIGHT ON WALLS = +48" TO TOP UON (PER ADA)	ATS	AUTOMATIC TRANSFER SWITCH
	DEVICES MOUNTED IN OR ABOVE BACKSPLASH: MAXIMUM HEIGHT ON WALLS = +48" TO TOP UON (PER ADA)	BKBD	BACKBOARD
Ф₽▽	DEVICES IN MULTI-COMPARTMENT FLUSH FLOOR MOUNTED UON	c	CONDUIT (WITH PULL CORD IF OTHERWISE EMPTY)
=	RECEPTACLE - DUPLEX	cu	COPPER
=	RECEPTACLE - DUPLEX - HALF SWITCHED (TOP HALF)	(E)	EXISTING TO REMAIN
•	RECEPTACLE - DUPLEX - INTEGRAL GFCI CIRCUITRY	F	FUSE (DUAL-ELEMENT, TIME DELAY)
=	RECEPTACLE - DUPLEX - 190LATED GROUND (ORANGE FACE): NEMA 520R/IG	FB0	FURNISHED BY OTHERS
⊕ =	RECEPTACLE - DOUBLE DUPLEX	FPEN	FUSE PER EQUIPMENT NAMEPLATE
₩	RECEPTACLE - DOUBLE DUPLEX - INTEGRAL GFCI CIRCUITRY	GFCI	GROUND FAULT CIRCUIT INTERRUPTER
₩ <u></u>	RECEPTACLE - SPECIAL TYPE (SEE ADDITIONAL NOTES)	GND	GROUND
Φ + Φ		HOA UR	HAND-OFF-AUTOMATIC
п н н	PLUG MOLD SURFACE RACEWAY SYSTEM (2-CIRCUIT WITH	HP IG:	HORSEPOWER ISOLATED GROUND
₽	OUTLETS 18" O.C. U.O.N.) MOUNTED ABOVE BACKSPLASH U.O.N.	K	KCMIL (300 KCMIL = 300K)
_	TELEPOWER POLE SMOKE DETECTOR - LOCAL ONLY, 120V, W/INTEGRAL BATTERY	Z ZF	NON-FUSED
@	AND ALARM HORN. WALL MOUNT AT 12" BELOW CEILING	NIC	NOT IN CONTRACT
€	SMOKE DETECTOR - LOCAL ONLY, 120V, W/INTEGRAL BATTERY, STROBE, AND ALARM HORN. WALL MOUNT AT 12" BELOW CEILING	NL	NIGHT LIGHT
Ф	OUTLET - CLOCK	NITG	NOT TO SCALE
	TO OUT IT AND	NTS	NOT TO SCALE

OUTLET - VOICE / DATA

OUTLET - TELEVISION

OUTLET - TELEPHONE

OUTLET - MICROPHONE

(MOUNTING PER PLANS)

OUTLET - DOOR BELL/BUZZER

OUTLET - VOLUME CONTROL (+48" TO TOP UON)

OUTLET - SPEAKER 8" COAXIAL W/ BACK BOX AND GRILLE

OUTLET - THERMOSTAT (REF. MECHANICAL DRAWINGS)

TV / SECURITY CAMERA - PTZ - PAN, TILT, ZOOM

TY / SECURITY CAMERA - FIXED (MOUNTING PER PLANS)

OUTLET - DATA



UNSWITCHED

XFMR TRANSFORMER

UNSW

EXISTING TO BE RELOCATED

UNINTERRUPTIBLE POWER SUPPLY


TRANSIENT VOLTAGE SURGE SUPPRESSION

RIGID GALVANIZED STEEL

UNLESS OTHERWISE NOTED

EXISTING TO BE REMOVED

WEATHER PROOF (NEMA 3R)

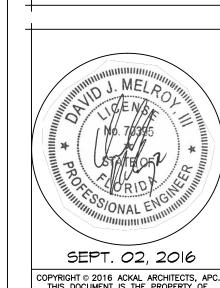

COPYRIGHT © 2016 ACKAL ARCHITECTS, APC.
THIS DOCUMENT IS THE PROPERTY OF
ACKAL ARCHITECTS, APC. THIS DOCUMENT MAY NOT BE COPIED,
REPRODUCED OR USED WITHOUT
WRITTEN CONSENT FROM
ACKAL ARCHITECTS, APC.

proj. no. 16-002 date: 08-02-2016

project architect:B.A <u>project manager: A.D.</u> <u>drawn by: MSA</u>

file name:LAKEWORTH revised: <u>/3\</u> ADDENDUM NO. 3, 09-02-2016 plot scale: AS NOTED sheet name: SYMBOL LIST AND GENERAL NOTES

sheet no.

33 of 42

	LIGHTIN	G CONT	ROL PANI	el 'Lcpi' schedule	PANEL: 16 RELAYS						
RELAY NUMBER	PANEL CIRCUIT	RELAY VOLTAGE	CONTROL ZONE	LOAD LOCATION/DESCRIPTION							
RI	L1-2	1200		DONOR FLOOR LIGHTING							
R 2	L1-4	1200		DONOR FLOOR LIGHTING							
R 3	L1-6	1200		DONOR FLOOR LIGHTING							
R4	L1-8	1200		DONOR FLOOR LIGHTING							
R5	L1-10	1200		RESTROOM / VITALS LIGHTIN	NG.						
R6	L1-12	1200		WAITING LIGHTING							
RT	L1-14	1200		WAITING / ENTRY LIGHTING	:						
RS	L1-16	1200		STERILE SUPPLIES LIGHTING	G						
R 9	L1-18	1200		BOH CORRIDOR LIGHTING							
RIØ	L1-20	1200		PLASMA PROC / OFFICE LIGHT	TING						
RII	L1-22	1200		BREAK ROOM / EXAM LIGHT	NG						
R12	L1-24	1200		CONF / RR LIGHTING							
R 13		1200		SPARE							
RI4		120V SPARE									
RI5		1200		SPARE							
RI6		1204		SPARE							

	LIGHTIN	G CONT	ROL PAN		PANEL: 16 RELAYS
RELAY NUMBER	PANEL CIRCUIT	RELAY VOLTAGE	CONTROL ZONE	LOAD LOCATION/DESCRIPTION	
RIT	L1-26	1204		EXTERIOR LIGHTING	
RIS	M1-29	1204		EF-1	
R19	MI-31	1204		EF-2	
R2Ø	M1-33	1204		EF-3	
R 21		1200		SPARE	
R22		1204		SPARE	
R23		1204		SPARE	
R24		1204		SPARE	
R25		1204		SPARE	
R26		1204		SPARE	
R27		1204		SPARE	
R28		1204		SPARE	
R29		1204		SPARE	
R3Ø		1204		SPARE	
R 31		1204		SPARE	
R32		1200		SPARE	

7.05	DECODIDATION	LOAD	DDEAKED	OVT	++	OVT	DDE MED	LAAD	DECODIDATION	T) (D)
TYPE	DESCRIPTION	LOAD	BREAKER	CKT	Н		BREAKER		DESCRIPTION	TYP
	DONOR MACHINE RECEPTACLES		20/1	1 -	•	† 2	_		DONOR MACHINE RECEPTACLES	
	DONOR MACHINE RECEPTACLES		20/1	<u>3</u> -	1	<u>† 4</u>		1500	DONOR MACHINE RECEPTACLES	
	DONOR MACHINE RECEPTACLES	1500	_	<u>5</u> -	Ħ	<u>♦</u> 6		1500	DONOR MACHINE RECEPTACLES	
	DONOR MACHINE RECEPTACLES	1500	20/1	7 -	•	+ 8			DONOR MACHINE RECEPTACLES	
	DONOR MACHINE RECEPTACLES	1500	20/1	9 -	1	 1 0	20/1	1500	DONOR MACHINE RECEPTACLES	
	DONOR MACHINE RECEPTACLES	1500	2Ø/1	11 -	H	• 12	20/1	1500	DONOR MACHINE RECEPTACLES	
	DONOR MACHINE RECEPTACLES	1500	20/1	<u>13</u> -	♦ ┼	 1 4		1500	DONOR MACHINE RECEPTACLES	
	DONOR MACHINE RECEPTACLES	1500	20/1	15 -	╁╪	 1 6	2Ø/1	360	DONOR FLOOR MAINTENANCE RECEPTACLES	
	DONOR MACHINE RECEPTACLES	1500	20/1	17 -	Н	• 18	20/1	360	DONOR FLOOR MAINTENANCE RECEPTACLES	
	RECEPTION RECEPTACLES	720	20/1	19 -	┿┼	 20	2Ø/1	900	DONOR FLOOR TY RECEPTACLES	
	RECEPTION RECEPTACLES	720	20/1	21-	┪	 22	20/1	900	DONOR FLOOR TV RECEPTACLES	
	RECEPTION RECEPTACLES	720	20/1	23-	H	┿ -24	2Ø/1	1080	REPAIR RECEPTACLES	
	RECEPTION RECEPTACLES	720	20/1	25-	┡┤	 26	2Ø/1	360	JANITOR/ REPAIR RECEPTACLES	
	RECEPTION RECEPTACLES	720	20/1	27-	+	- 28	20/1		SPARE	
	RECEPTION RECEPTACLES	720	20/1	29-	H	- 30	2Ø/1		SPARE	
	RECEPTION RECEPTACLES	720	20/1	31 -	•	+32	20/1		SPARE	
	RECEPTION RECEPTACLES	540	20/1	33-	+	+34	20/1		SPARE	
	RECEPTION RECEPTACLES	72Ø	20/1	35-	Ħ	♦ -36	20/1		SPARE	
	SPARE		20/1	<u>3</u> 7-	♦┼	- 38	20/1		SPARE	
	SPARE		20/1	39-	•		20/1		SPARE	
	SPARE		20/1	41 -	H	♦ -42	20/1		SPARE	
OLTS: (208/120V, 3ø, 4W.				11	1			TOTAL LOAD: 34 KVA (95
MPS:	100A • 225A · 400A · .								TOTAL EGAL.	
MAIN:) MCB .									
	<u> </u>									
.UGS: (9								NEUTRAL DUO A 400M	
	SURFACE FLUSH	11				^		11	NEUTRAL BUS: • 100% 200%	
JUSS: (O COPPER ALUMINUM D DOOR IN DOOR STANDARD				L	_			GROUND BUS: STANDARD ISOLATED AIC RATING: 10K 14K 22K 3	

									NEMA RATING: 1														
TYPE	DESCRIPTION	LOAD	BREAKER	СКТ	+	СКТ	BREAKER	LOAD	DESCRIPTION	TYPE													
	VENDING RECEPTACLE	1200	20/1	1 -	#	- 2	30/1		IT UPS RECEPTACLE														
	VENDING RECEPTACLE	1200	20/1	3 –	•	$-\frac{1}{4}$	3Ø/1	2200	IT UPS RECEPTACLE														
	HAND DRYER	1500	20/1	5 -	+	- 6	3Ø/1	2200	IT UPS RECEPTACLE														
	HAND DRYER	1500	20/1	7 -	+	8	2Ø/1	1200	TBB RECEPTACLE														
	EWC RECEPTACLE	600	20/1	9 -	•	-10	20/1	1200	TBB RECEPTACLE														
	HAND DRYER	1500	20/1	11 –	+	-12	20/1	400	FA PANEL														
	HAND DRYER	1500	20/1	13⊀	+	- 14	20/1	1080	PLASMA PROCESSING RECEPTACLES														
	RR RECEPTACLES	360	20/1	15 -	+	- 16	20/1	72Ø	PLASMA PROCESSING RECEPTACLES														
	MAINTENANCE/TY RECEPTACLES	660	20/1	17 -	\pm	- 18	20/1	1080	PLASMA PROCESSING RECEPTACLES														
	KIOSK RECEPTACLES	900	20/1	19⊀	+	- 20	20/1	540	PLASMA PROCESSING RECEPTACLES														
	KIOSK RECEPTACLES	900	20/1	21 -	•	- 22	20/1	1080	PLASMA PROCESSING RECEPTACLES														
	SPARE		20/1	23 -	$oldsymbol{+}$	-24	20/1	1440	MAINTENANCE RECEPTACLES														
	SPARE		20/1	25⊀	+	- 26	20/1	360	PLASMA PROCESSING RECEPTACLES														
	SPARE		20/1	27 -	•	- 28	20/1	72Ø	CONFERENCE RECEPTACLES														
	SPARE		20/1	29 -	$oldsymbol{+}$	- 30	20/1	1080	CONFERENCE RECEPTACLES														
	SPARE		20/1	31⊀	\pm	- 32	2Ø/1	1080	CONFERENCE RECEPTACLES														
	SPARE		20/1	33-	+	- 34	20/1	720	OFFICE RECEPTACLES														
	SPARE		20/1	35 -	\pm	- 36	2Ø/1	720	OFFICE RECEPTACLES														
	SPARE		20/1	37 -	\pm	- 38	20/1	1080	OFFICE RECEPTACLES														
	SPARE		20/1	39 -	+	- 40	2Ø/1	360	RESTROOM RECEPTACLES														
	SPARE		20/1	41 -	\pm	- 42	20/1		SPARE														
VOLTS:	208/120V, 3ø, 4W.			l					TOTAL LOAD: 33 KVA (92 A)													
AMPS:	100A • 225A · 400A · .																						
MAIN:	MCB . • MLO																						
LUGS:) DBL. LUGS FEED-THRU																						
_	SURFACE FLUSH								NEUTRAL BUS:														
_	COPPER ALUMINUM	11		I		2		- 11	GROUND BUS: STANDARD ISOLATED														
_	DOOR IN DOOR STANDARD			↓					AIC RATING: 10K 14K 22K 3	35K													
DOON.	DOON IN DOON STANDAND								AIC IATHRO. CION CITA CZZN														

TYPE	DESCRIPTION	LOAD	BREAKER	CKT	$\dashv \uparrow$	CKI	· R	REAKER	LOAD	DESCRIPTION	TYPE
11111	DECOM NOV	LOND	60 /	1	4	_	_	20/1	500	FREEZER LIGHTS	1112
	FZCU-1 / FZEU-1	15130		3	1		=-	20/1	500	FREEZER LIGHTS	
		10.00	/ 3	5	#		-	20/1	500	FREEZER LIGHTS	
		4330	30/	7	•	_	-	20/1	500	FREEZER THERMOSTAT	
	FZCU-2 / FZEU-2		/ 2	9	+	+ 1	_	20/1	500	FREEZER TEMPERATURE MONITORING	
			60/	11	\dashv	• 1.		20/1	500	· · · · · · · · · · · · · · · · · · ·	~ ~ ~
	FZCU-3 / FZEU-3	15130		13	•	+ 1	4 :	20/1	500	FAN	
			/ 3	15	+	1	6 2	2Ø/1		SPARE	
		1000	20/1	17	\blacksquare	+ 1	8 :	2Ø/1		SPARE	
	DRAIN HEATERS	1000	20/1	19	 	+2	0 2	20/1		SPARE	
	DRAIN HEATERS	1000	20/1	21	+	+2	2 3	2Ø/1		SPARE	
	DRAIN HEATERS		20/1			+ 2	4 :	2Ø/1		SPARE	
	SPARE		20/1	25	+	 1 2	6 2	20/1		SPARE	
	SPARE		20/1	27	++	 2	8 2	2Ø/1		SPARE	
	SPARE		20/1			 3	0 :	2Ø/1		SPARE	
	SPARE		2Ø/1	31	 	 3	2 3	20/1		SPARE	
	SPARE		2Ø/1		++	 3	4 :	20/1		SPARE	
	SPARE		2Ø/1	35	$\pm \pm$	- 3	6 2	20/1		SPARE	
	SPARE		2Ø/1	37	 	 3	8 2	20/1		SPARE	
	SPARE		2Ø/1	39	++	+4	0 2	20/1		SPARE	
	SPARE		20/1	41	+	- 4	2 3	20/1		SPARE	
/OLTS: 🤇	● 208/120V, 3ø, 4W.				1 1	1				TOTAL LOAD: 41 KVA (114 A)
AMPS: (○ 100A ● 225A ○ 400A ○ .										
AAIN: (MCB . • MLO										
.ugs: (DBL. LUGS FEED-THRU										
	SURFACE FLUSH									NEUTRAL BUS: 100% 200%	
	COPPER ALUMINUM	11			— /	\sim 1			11	GROUND BUS: STANDARD ISOLATED	

						ě				١	NEMA RATING: 1	
TYPE	DESCRIPTION	LOAD	BREAKER	CKT	#		BREAKER	LOAD		DESCRIPTIO	N	TYPE
			50/	1 -	\pm	 2						
	RTU-1	13080		3 -	•	<u> </u>		9910	RTU-5			
			/ 3	5 -	\pm	- 6						-
	D+11 2	10000	45 /	/ -	Ŧ		40/	0010	5			+
	RTU-2	10880	/ 3	9 –		<u>+</u> 10 •12		3310	RTU-6			+
			60 /	13-	Н		35 /					+
	RTU-3	13840		15		- 16		8580	RTU-7			+
		13040	/ 3		1	- 18		0300	1213			+
			60/	19 -	\pm		20/1	1440	ROOF MAIN	NTENANCE F	RECEPTACLES	3
	RTU-4	13840		21-	•		35 /					+-
			/ 3		#	<u>-24</u>		8580	RTU-8			\top
	FC-1 / CU-1	2810	20/	25-	\mp	-26						
			/ 2	<u> </u>	+		2Ø/1		SPARE			
-	EF-1	410	20/1		\pm		20/1		SPARE			
-	EF-2	410	2Ø/1	31-	\pm	 32	20/1		SPARE			
\sim	EF-3	410	20/1	33-	•	 34			SPARE			
	SPARE	, i	20/	35-	+	-36			SPARE			
~~~		تست	2	<u> </u>	$\pm$	<del>-38</del>						-
	SPARE		20/1		1	<u> </u>		11000	WH-1			+
	SPARE		20/1	4  7	$\mp$	<b>-</b> 42	/ 3					
•	208/120V, 3ø, 4W.			•	•	•			TOTAL LOAD:		100 KVA (	277
•	100A 225A • 400A .											
	MCB _											
	DBL. LUGS FEED-THRU											
	SURFACE FLUSH	11			د	1		1.1	NEUTRAL BUS:	100%	200%	_
	COPPER ALUMINUM	• •							GROUND BUS:	STANDA	_	
DOOR: (	DOOR IN DOOR STANDARD								AIC RATING:		) 14K 🔵 22K 🗨	) <u>35K</u>

SHEET NOTES:

ROUTE CIRCUIT THROUGH LIGHTING CONTROL PANEL 'LCPI'.

2 ROUTE CIRCUIT THROUGH LIGHTING CONTROL PANEL 'LCP2'.

TYPE	DESCRIPTION	LOAD	BREAKER	R CKT	$\top$	СКТ	BREAKER	LOAD	DESCRIPTION	TYPE
11111	OFFICE RECEPTACLES	720	20/1	1		<b>+</b> " 2	_	1440	DONOR FLOOR LIGHTING	11111
	OFFICE RECEPTACLES	720	_	3	1	+ 4		1440	DONOR FLOOR LIGHTING	
	OFFICE RECEPTACLES	720	20/1		#	<b>+</b> 6		1200	DONOR FLOOR LIGHTING	
	OFFICE RECEPTACLES	720	_	7	•	<del> </del>		1200	DONOR FLOOR LIGHTING	
	OFFICE RECEPTACLES	720	20/1	9	+	10		960	RESTROOM/VITALS LIGHTING	
	OFFICE RECEPTACLES	72Ø	20/1	111	#	<b>→</b> 12		1200	WAITING LIGHTING	
	OFFICE RECEPTACLES	72Ø	2Ø/1	13	•	+14	20/1	880	WAITING/ENTRY LIGHTING	
	OFFICE RECEPTACLES	720	20/1	15	+	16		1120	STERILE SUPPLIES LIGHTING	
	OFFICE RECEPTACLES	720	20/1	17	++	<b>∳</b> -18	20/1	1200	BOH CORRIDOR LIGHTING	
	OFFICE RECEPTACLES	1080	2Ø/1	19	•	+20	2Ø/1	960	PLASMA PROC/OFFICE LIGHTING	
	EXAM RECEPTACLES	900	20/1	21	+	<del>  2</del> 2	20/1	1200	BREAK ROOM/EXAM LIGHTING	
	EXAM RECEPTACLES	900	2Ø/1	23	₩	<del>•</del> -24	2Ø/1	880	CONF/RR LIGHTING	
	EXAM RECEPTACLES	300	2Ø/1	25	+	<del> </del> 26	20/1	200	EXTERIOR LIGHTING	
	REFRIGERATOR RECEPTACLE	1200	2Ø/1	27	++	<del> </del> 28	20/1	540	RECEPTION RECEPTACLES	
	REFRIGERATOR RECEPTACLE	1200	2Ø/1	29	++	<del>  3</del> 0	2Ø/1	540	RECEPTION RECEPTACLES	
	MICROWAVE RECEPTACLE	1200	2Ø/1	31	<del> </del>	<del>  1</del> 32	20/1	1080	RECEPTION RECEPTACLES	
	MICROWAVE RECEPTACLE	1200	2Ø/1	33	++	<del> </del> 3∠	- 20/1	1500	COPIER RECEPTACLE	
	BREAK COUNTER RECEPTACLE	180	2Ø/1	35	#	<del>  3</del> 6	20/1	88Ø	FUTURE OFFICE SPACE LIGHTING	
	BREAK COUNTER RECEPTACLE	180	2Ø/1	37	++	<del>  3</del> 8	20/1		SPARE	
	BREAK COUNTER RECEPTACLE	180	20/1	39	++	<del>    4</del> 0	20/1		SPARE	
	DISHWASHER RECEPTACLE	1200	2Ø/1	<u> 41</u>	#	<b>◆</b> -42	20/1		SPARE	
OLTS: 🤇	<b>●</b> 208/120V, 3ø, 4₩.				1 1	ı			TOTAL LOAD: 35 KVA (	98 A)
MPS: 🤇	● 100A ○ 225A ○ 400A ○ <u>.                                   </u>									
IAIN: (	→ MCB . • MLO									
ugs: 🤇	DBL. LUGS FEED-THRU									
ITD:	SURFACE FLUSH								NEUTRAL BUS:	
	COPPER ALUMINUM	11				1		11	GROUND BUS: STANDARD ISOLATED	



ESSIONAL CORPORA

C H T T

A R C HAFEL DRIVE - LAFAY 337 - 9

INTERIOR TENANT IMPROVEMENT FOR:

| MMUNOTER big | Depot Plaza, suite b-5 | Lake morth, palm beach county, fi

SEPT. 02, 2016

COPYRIGHT © 2016 ACKAL ARCHITECTS, APC. THIS DOCUMENT IS THE PROPERTY OF ACKAL ARCHITECTS, APC. THIS DOCUMENT MAY NOT BE COPIED, REPRODUCED OR USED WITHOUT WRITTEN CONSENT FROM ACKAL ARCHITECTS, APC.

proj. no. 16-002 date: 08-02-2016 project architect:BA

project architect:B.A.

project manager: A.D.

drawn by: MSA


file name:LAKEWORTH
revised: ADDENDUM NO.3, 04-02-2016
plot scale: AS NOTED
sheet name:
PANEL

SCHEDULES
sheet no.

- 1. THE CONTRACTOR SHALL COORDINATE THE EXACT MOUNTING LOCATION OF ALL DEVICES WITH THE ARCHITECTURAL DRAWINGS PRIOR TO ROUGH-IN.
- 2. ALL BRANCH CIRCUITS SHALL BE ROUTED WITH A DEDICATED NEUTRAL CONDUCTOR PER EACH PHASE CONDUCTOR.
- 3. ALL RECEPTACLES LOCATED IN PATIENT CARE AREAS SHALL BE HOSPITAL GRADE RECEPTACLES WITH GREEN DOT.
- 4. ALL BRANCH CIRCUITS INSTALLED IN PATIENT CARE AREA SHALL CONTAIN A REDUNDANT GROUNDING CONDUCTOR PER NEC ARTICLE 517. UP-SIZE CONDUIT SIZE AS NECESSARY TO ACCOMMODATE ADDITIONAL GROUND CONDUCTOR.
- 5. THE CONTRACTOR SHALL REFER TO ARCHITECTURAL ELECTRICAL ENLARGED PLANS ON SHEETS A9.5 AND A9.6 FOR EXACT OUTLET PLACEMENT FOR THE FOLLOWING ROOMS: PLASMA PROCESSING, CONTROL, EXAM ROOMS AND OFFICES. ARCHITECTURAL ENLARGED PLANS ARE TO TAKE PRECEDENCE FOR OUTLET LOCATIONS.
- 6. ALL PANELS SHALL BE PROVIDED WITH A LOCKABLE COVER.
- 1. ALL DEVICES AND FACEPLATES SHALL BE WHITE. THE CONTRACTOR SHALL COORDINATE BETWEEN ELECTRICAL AND LOW VOLTAGE TRADES TO ENSURE THAT POWER AND LOW VOLTAGE DEVICE AND FACEPLATES MATCH. PROVIDE SAMPLES TO TENANT FOR FINAL COLOR SELECTION.

# SHEET NOTES:

- EXTEND AND CONNECT CIRCUITING FROM JUNCTION BOX TO OUTLETS IN AREA WITH SAME CIRCUIT NUMBERS, ROUTE #12 CONDUCTORS (MINIMUM) THROUGHOUT, UNLESS NOTED OTHERWISE.
- JUNCTION BOX FOR CONNECTION TO FREEZER DRAIN HEATERS. VERIFY EXACT LOCATION AND CONNECTION REQUIREMENTS WITH FREEZER SHOP DRAWINGS. PROVIDE RECEPTACLE AND CORD CAP AS REQUIRED. INCLUDE 1/2" CONDUIT WITH 2 #14 TO PRESSURE RELIEF YALVE AND 1/2" CONDUIT WITH 2 #12 TO DOOR FRAME HEATER.
- JUNCTION BOX FOR CONNECTION TO HAND DRYER. VERIFY EXACT MOUNTING LOCATION AND CONNECTION REQUIREMENTS WITH THE MANUFACTURER'S INSTALLATION INSTRUCTIONS.
- JUNCTION BOX FOR CONNECTION TO FREEZER LIGHTS. VERIFY EXACT MOUNTING LOCATION AND CONNECTION REQUIREMENTS WITH FREEZER SHOP DRAWINGS. ELECTRICAL CONTRACTOR SHALL MOUNT FREEZER LIGHTS PER APPROVED SHOP DRAWINGS.
- THE CONTRACTOR SHALL PROVIDE CONNECTION FROM OUTDOOR UNIT (ON ROOF) TO INDOOR UNIT. PROVIDE POWER AND CONTROL CONDUITS AND CONDUCTORS PER FREEZER SHOP DRAWINGS.
- PROVIDE NEMA-L5-30R FOR DATA RACK UPS EQUIPMENT. VERIFY EXACT MOUNTING LOCATION WITH THE IT EQUIPMENT INSTALLER PRIOR TO
- DELIVERY PUSH BUTTON AND CHIME. COORDINATE EXACT MOUNTING LOCATIONS AND MOUNTING HEIGHTS WITH THE OWNER'S REPRESENTATIVE PRIOR TO ROUGH-IN.
- PROVIDE RECEPTACLE FOR FREEZER TEMPERATURE MONITORING EQUIPMENT. VERIFY EXACT MOUNTING LOCATION WITH THE FREEZER SHOP DRAWINGS PRIOR TO ROUGH-IN.
- DEVICES ARE MOUNTED IN A MULTI-COMPARTMENT FLOOR BOX. REFER TO E2.1 FOR ADDITIONAL INFORMATION. COORDINATE COVER PLATE STYLE WITH THE INSTALLED FLOOR COVERING IN ORDER TO PROVIDE A FLUSH FLOOR INSTALLATION.
- PROVIDE RECEPTACLE FOR VENDING MACHINE. COORDINATE EXACT MOUNTING LOCATION WITH THE INSTALLED EQUIPMENT SHOP DRAWINGS.
- SUGGESTED LOCATION FOR FIRE ALARM PANEL. VERIFY EXACT MOUNTING LOCATION WITH THE FIRE ALARM DESIGNER. PROVIDE DUPLEX RECEPTACLE FOR FIRE ALARM PANEL.
- DEVICES MOUNTED IN MILLWORK. COORDINATE DEVICE LOCATION, CONDUIT ENTRY, ETC. WITH THE MILLWORK SHOP DRAWINGS.
- PROVIDE RECEPTACLE FOR SOUND BAR. VERIFY EXACT MOUNTING LOCATION WITH THE ARCHITECTURAL ELEVATIONS PRIOR TO ROUGH-IN.
- PROVIDE JUNCTION BOX FOR 120V CONNECTION TO FREEZER THERMOSTATS. VERIFY EXACT MOUNTING LOCATION WITH APPROVED SHOP DRAWINGS. ROUTE 18 GAUGE SHIELDED 2 CONDUCTOR CABLE FROM THERMOSTAT TO RESPECTIVE FREEZER TEMPERATURE SENSOR (ONE FOR EACH FREEZER).
- PROVIDE CONNECTION FROM INDOOR UNIT TO OUTDOOR UNIT PER THE MANUFACTURER'S INSTALLATION INSTRUCTIONS.
- (16) AREA NOT IN SCOPE.
- MICROWAVE OUTLET TO BE MOUNTED IN CABINET BELOW. VERIFY EXACT MOUNTING LOCATION WITH THE ARCHITECTURAL DRAWINGS PRIOR TO ROUGH-IN.
- MICROWAVE OUTLET TO BE MOUNTED IN CABINET ABOVE. VERIFY EXACT MOUNTING LOCATION WITH THE ARCHITECTURAL DRAWINGS PRIOR TO ROUGH-IN.
- PROVIDE RECEPTACLE FOR FAN FURNISHED AND INSTALLED BY OTHERS.

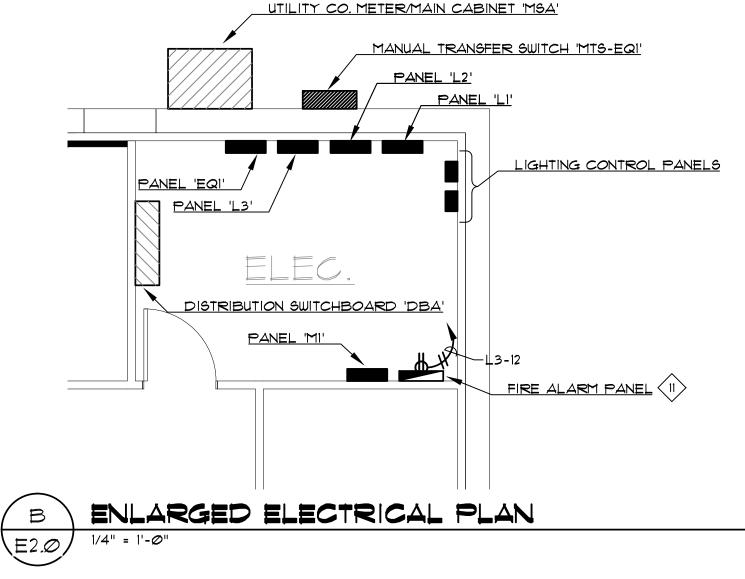




A PROFESSIONAL CORPOR

A R C HAPET 337 - 988 - 5271 ph. - 337 - 988

INTERIOR TENANT IMPROVEMENT FOR:

| MMUNOTEK BIO OENTERO, LLO
4550 LAKE MORTH ROAD
OFFICE DEPOT PLAZA, SUITE B-5
LAKE MORTH, PALM BEACH COUNTY, FL 93

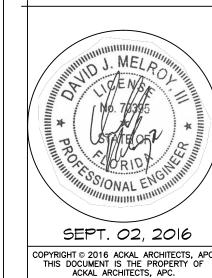

THIS DOCUMENT IS THE PROPERTY OF ACKAL ARCHITECTS, APC.
THIS DOCUMENT WAY NOT BE COPIED REPRODUCED OR USED WITHOUT WRITTEN CONSENT FROM ACKAL ARCHITECTS, APC.

proj. no. 16-002 date: 08-02-2016 project architect:B

project architect:B.A project manager:A.D drawn by:MSA

file name: LAKEWORTH
revised: 3 ADDRINUM NO. 3, 04-02-2016
plot scale: AS NOTED
sheet name:

POWER
PLAN
Sheet no.

sheet no. = 2.0


proj. no. 16-002 date: 08-02-2016


project architect:B.A. project manager: A.D. drawn by: MSA file name:LAKEWORTH

revised: /3\ ADDENDUM NO. 3, 09-02-2016 plot scale: AS NOTED lsheet name: SIGNAL

sheet no.

PLAN

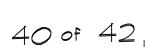

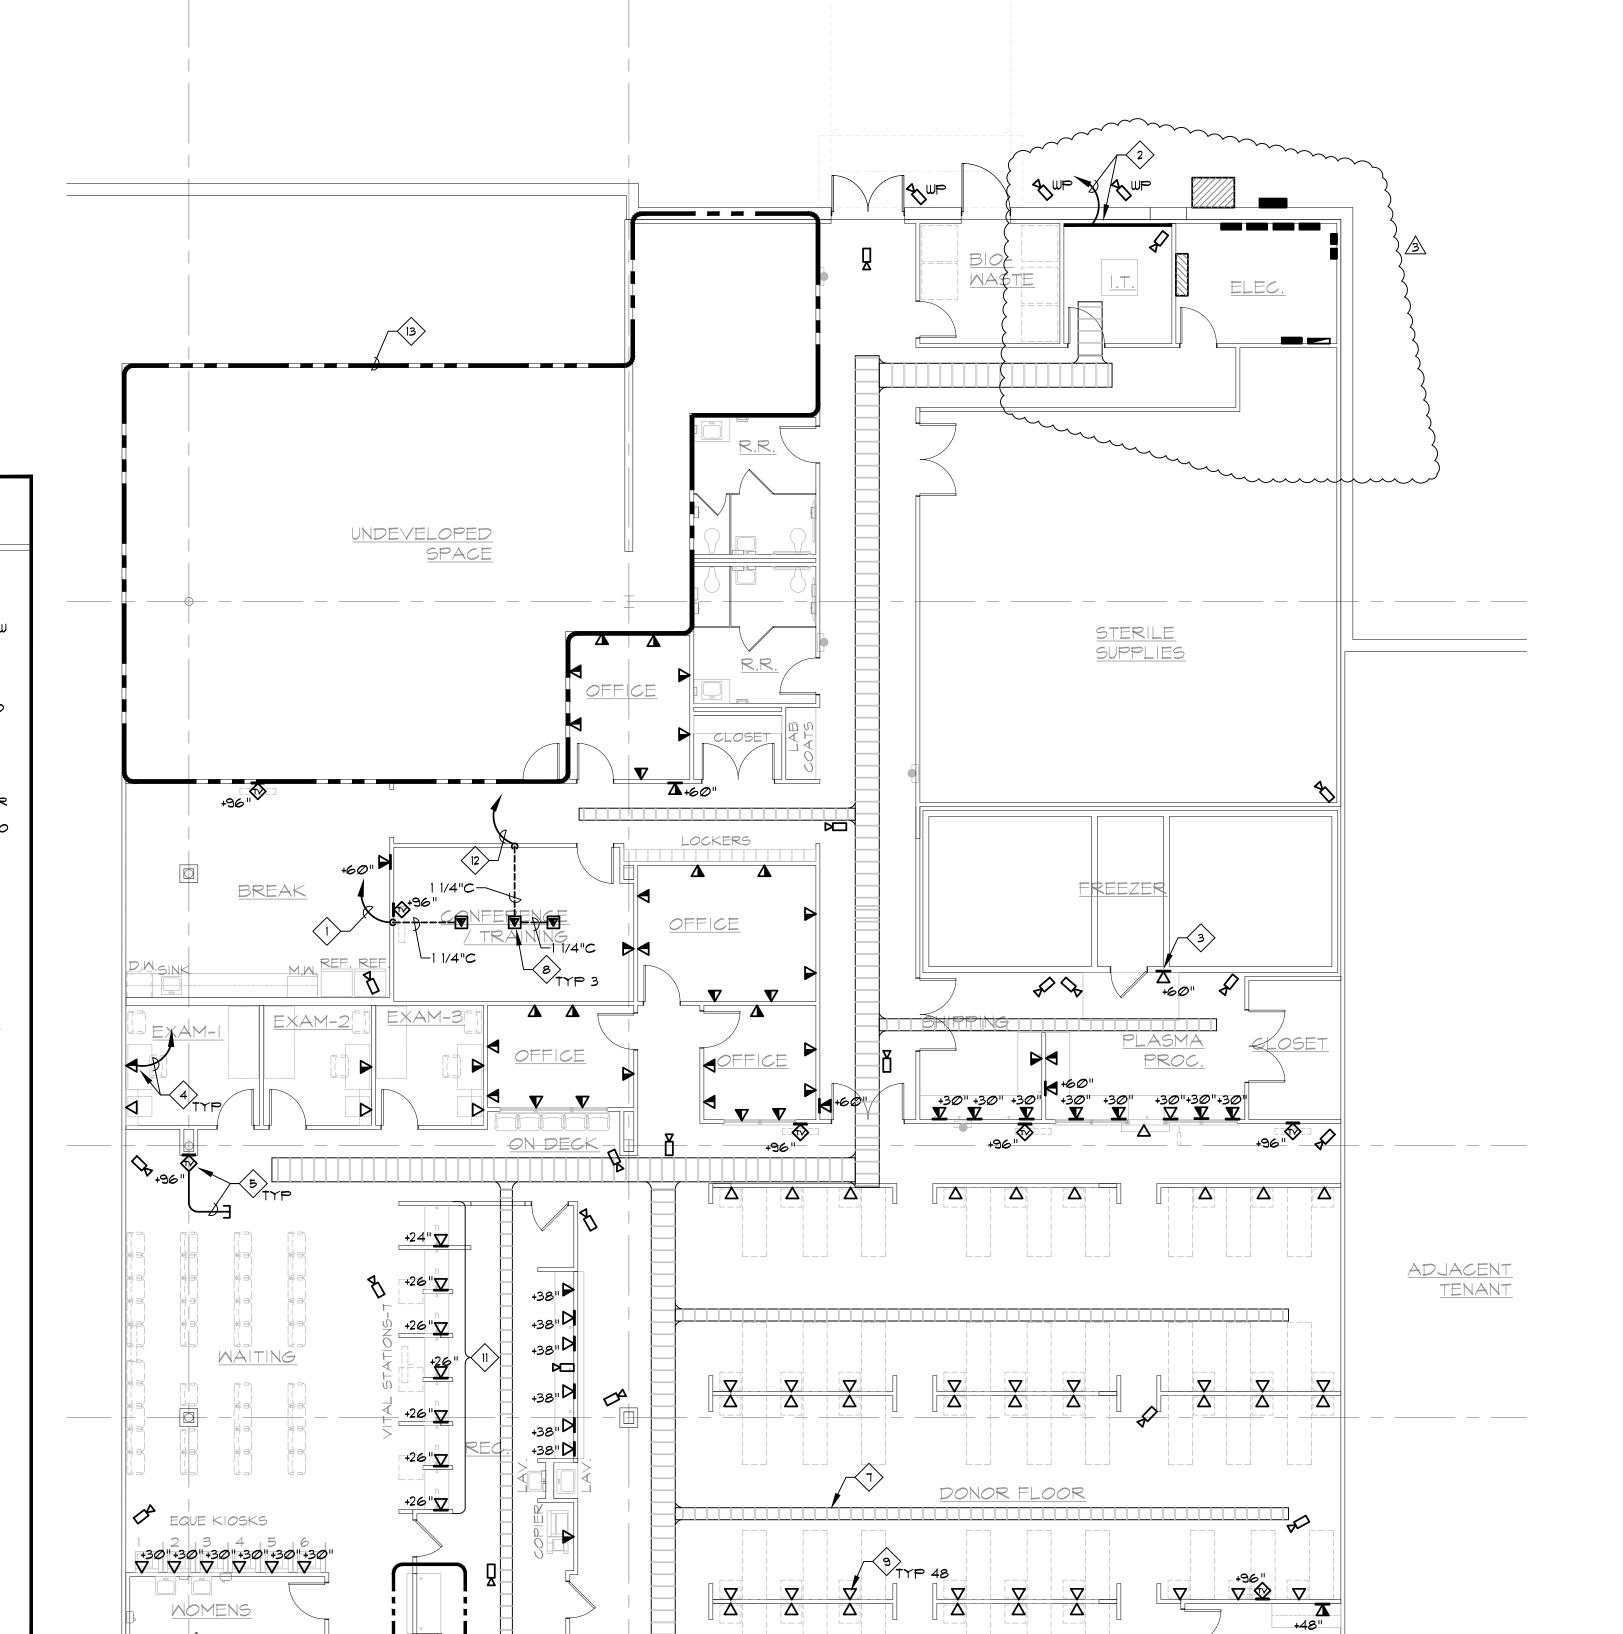

REPAIR

JAN.

**196"** ∇ **1** 

+24"||+24" |----||**||||**||||

SIGNAL PLAN

E2.1

CANOPY

# LOW YOLTAGE REQUIREMENTS

# CONTRACTORS RESPONSIBILITIES:

- PROVIDE AND INSTALL CABLE TRAY, CONDUIT AND JUNCTION BOXES IN WALLS AND ABOVE/BELOW COUNTERS FOR NETWORK DROPS.
- PROVIDE CONDUIT IN WALLS FROM THE JUNCTION BOX TO ABOVE THE WALL FOR EACH. WHERE CEILING IS PLENUM RATED, PROVIDE CONTINUOUS CONDUIT FOR A WIRING WITHIN CEILING.
- CONDUIT STUBBED ABOVE THE CEILING SHALL RECEIVE A PLASTIC RING TO PREVENT DAMAGE TO WIRING DUE TO RUBBING THE CUT END OF THE CONDUIT.
- ALL LOW VOLTAGE CABLES ARE TO BE ROUTED WITHIN THE LOW VOLTAGE CABLE TRAYS TO THE MAXIMUM EXTENT POSSIBLE.
- PROVIDE AND INSTALL FULLY MONITORED AND CODE APPROVED FIRE ALARM SYSTEM. THE CONTRACTOR IS RESPONSIBLE FOR HIRING A STATE LICENSED FIRE ALARM SYSTEM COMPANY FOR DESIGN AND INSTALLING THE COMPLETE SYSTEM. THE DESIGN AND SUBMITTALS FOR THIS SYSTEM SHALL BE PROVIDED BY THE CONTRACTORS LICENSED FIRE ALARM COMPANY AND SUBMITTED TO ANY AND ALL STATE AND OR LOCAL AGENCIES AS REQUIRED FOR REVIEW AND APPROVAL. A

COPY OF THE SUBMITTAL SHALL ALSO BE SUBMITTED TO THE ARCHITECT FOR REVIEW PRIOR TO

## OWNER RESPONSIBILITIES:

SUBMITTING TO CODES FOR REVIEW.

- PROVIDE AND INSTALL RAW CABLING FOR DATA (CAT6), VOICE (CAT6), CATY, SURVEILLANCE CAMERAS, DETECTION AND BURGLARY ALARM SYSTEMS. FACEPLATES FOR VOICE/DATA, BLANK WALL PLATE INSERTS AND CATE WALL PLATE INSERTS SHALL BE PROVIDED AND INSTALLED BY
- TERMINATE ALL ETHERNET CAT6 CABLE RUNS AT BOTH WORKSTATIONS AND PATCH PANELS ENDS.
- TERMINATE CATY CABLES.
- . PROVIDE AND INSTALL TY SETS AND DYD PLAYERS.
- TEST CATY AND MOVIE PLAYER SYSTEM.
- ». TERMINATE CCTV CAMERA CABLES, INSTALL CAMERAS, CAMERA POWER AND DVR.
- PROVIDE AND INSTALL ALL VIDEO SURVEILLANCE CAMERAS, MOUNTS, RECORDER AND DISPLAY.
- . PROVIDE AND INSTALL ACCESS ALARM SYSTEM THAT MEET ALL CODE REQUIREMENTS.
- B. PROVIDE AND INSTALL FREEZER TEMPERATURE SENSOR, MONITORS AND ALARMS.
- IØ. PROVIDE AND INSTALL ALL COMPUTERS, PRINTERS, TIME CLOCKS AND OTHER USER EQUIPMENT.
- PROVIDE AND INSTALL RAW CABLING FOR DATA (CAT 6), VOICE (CAT 6), CATV, SURVEILLANCE CAMERAS, DETECTION AND BURGLARY ALARM SYSTEMS.

## OWNER RESPONSIBILITIES FOR NETWORK RACK INSTALLATION: (OWNER TO PROVIDE AND INSTALL)


- ENCLOSED 19" EQUIPMENT CABINET AND ACCESSORIES.
- . FLOOR BOLTS AND BOLTING OF RACK TO FLOOR.
- . SWITCH METERED PDU WITH ATS.
- 4. 24 AND 48 PORT PATCH PANELS.
- 5. 3.5" DIAMETER PVC PACK-TOP CONDUIT (STOVE PIPE).
- 5. RACK MOUNT UPS.
- UPS NETWORK MANAGEMENT CARD WITH TEMP SENSOR..
- 8. PATCH CABLES FOR RACK AND WORKSTATION.
- B. CENTRAL TELEPHONE SYSTEM (PBX) AND ACCESSORIES.
- 10. VIDEO SURVEILLANCE SYSTEM (DVR) AND ACCESSORIES.

PROVIDE 8'H X 3/4" X LENGTH AS INDICATED FIRE-RATED PLYWOOD (3) PROVIDE DATA OUTLET FOR FREEZER TEMPERATURE MONITORING EQUIPMENT. VERIFY EXACT LOCATION PRIOR TO ROUGH-IN.

RATED RG6 COAX CABLE TO 'TBB' VIA CABLE TRAY. LEAVE 10' OF SLACK CABLE AT TELE ROOM FOR TERMINATION BY OTHERS.

IN DATA ROOM VIA CABLE TRAY.

- (8) DEVICE IS MOUNTED IN A MULTI-COMPARTMENT, FLUSH FLOOR STYLE FLOOR BOX. REFER TO E2.0 FOR ADDITIONAL INFORMATION. COORDINATE COVER PLATE STYLE WITH THE INSTALLED FLOOR COVERING TO PROVIDE A FLUSH FLOOR INSTALLATION.
- (9) PROVIDE 45 JUNCTION BOX WITH SINGLE GANG MUD RING ADJACENT POWER RECEPTACLE FOR PLASMA MACHINE. PROVIDE 3/4" CONDUIT STUBBED FROM JUNCTION BOX TO CABLE TRAY. ROUTE (2) CAT 6 PLENUM RATED CABLES TO DATA RACK VIA CABLE TRAY.
- $\langle$ IIangle Devices mounted in Millwork. Coordinate device location, conduit

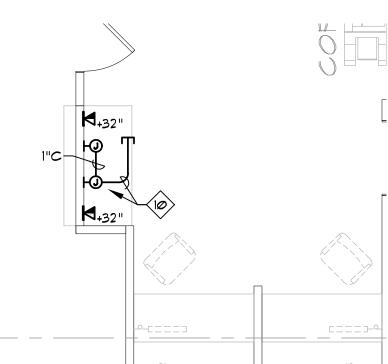

ENLARGED SIGNAL PLAN

MSA #L16029 ENGINEERING CONSULTANTS 370 E. Windmill Lane, Suite 100 Las Vegas, NV. 89123 T: (702) 896-1100 首為核

REPRESENTATIVE PRIOR TO ROUGH-IN.

GENERAL NOTES:

2. ALL VOICE/DATA CABLES SHALL BE CATEGORY 6. CABLES INSTALLED

OWNER'S I.T. STANDARDS PRIOR TO SUBMITTING BID.

VERIFY LOCATION OF ALL DEVICES WITH ARCHITECT/OWNER'S

3. THE CONTRACTOR SHALL INSTALL JUNCTION BOXES, RINGS AND CONDUITS FROM OUTLET JUNCTION BOX TO CABLE TRAY. PROVIDE NYLON BUSHING AT CONDUIT END. CONDUITS SHALL BE SIZED APPROPRIATELY TO FACILITATE QUANTITY OF CABLES AS DETERMINED BY THE OWNER'S

REPRESENTATIVE. 4. THE OWNER SHALL UTILIZE CABLE TRAY TO ROUTE ALL CABLES FROM THE DEVICE TO THE RACK/TELEPHONE BACKBOARD.

5. THE CONTRACTOR SHALL VERIFY ADDITIONAL REQUIREMENTS WITH THE

6. CABLE TRAY MAIN TRUNKS SHALL BE 12" WIDE. BRANCH TRUNKS SHALL BE 6" WIDE. SUBMIT CABLE TRAY FOR REVIEW.

1. DONOR FLOOR KNEE WALLS AND CONTROL AREA CONDUITS: ROUTE 1" CONDUIT MAXIMUM FOR (6) CAT 6 CABLES OR 3/4" CONDUIT WITH (4) CAT 6 CABLES. CABLE QUANTITY BY OWNER.

8. LOW YOLTAGE DEVICES AND FACEPLATE COLORS SHALL MATCH POWER DEVICE AND FACEPLATE COVERS. PROVIDE WHITE FACEPLATES.

9. ALL DEVICES AND FACEPLATES SHALL BE WHITE. THE CONTRACTOR SHALL COORDINATE BETWEEN ELECTRICAL AND LOW YOLTAGE TRADES TO ENSURE THAT POWER AND LOW VOLTAGE DEVICE AND FACEPLATES MATCH. PROVIDE SAMPLES TO TENANT FOR FINAL COLOR SELECTION.

## SHEET NOTES:

ROUTE 1 1/4" CONDUIT UP WALL TO CEILING SPACE ABOVE TY LOCATION.

BACKBOARD WITH 3/4" - 1 CU TO MAIN SERVICE PANEL GROUND BUS. ROUTE (2) 2" CONDUITS TO UTILITY COMPANY SERVICE ENTRANCE. VERIFY ADDITIONAL REQUIREMENTS WITH PHONE COMPANY PRIOR TO ROUGH-IN.

4) 3/4" CONDUIT STUB FROM VOICE/DATA OUTLET JUNCTION BOX TO CABLE TRAY. ROUTE (2) CAT 6 PLENUM RATED CABLES TO DATA RACK VIA CABLE TRAY. PROVIDE (1) CAT 6 CABLE FOR A SINGLE DATA OUTLET.

(5) 3/4" CONDUIT STUB FROM MATY OUTLET TO CABLE TRAY. ROUTE PLENUM

(6) ROUTE (1) PLENUM RATED CAT 6 CABLE FROM IP CAMERA TO DATA RACK

· SUGGESTED BASKET TRAY ROUTING. THE CONTRACTOR SHALL FIELD VERIFY ROUTING WITH THE OWNERS LOW VOLTAGE CONTRACTOR.

PROVIDE 46 JUNCTION BOX MOUNTED BELOW RECEPTION AREA FOR TY CONTROL. YERIFY EXACT MOUNTING LOCATION WITH IMMUNOTEK IT EQUIPMENT INSTALLER. ROUTE 1 1/4" CONDUIT WITH BUSHING TO ABOVE ACCESSIBLE CEILING. PROVIDE ANOTHER 45 JUNCTION BOX ADJACENT TY CONTROL JUNCTION BOX WITH I" CONDUIT BETWEEN.

ENTRY ETC. WITH THE MILLWORK SHOP DRAWINGS.

(12) ROUTE 1 1/4" CONDUIT UP WALL TO CABLE TRAY.

(13) AREA NOT IN SCOPE OF WORK.

E2.1

INTERIOR TENANT IMPROVEMENT FOR:

IMMUNOTER BIO OENTERO, ILO

4550 LAKE NORTH ROAD

OFFICE DEPOT PLAZA, SUITE B-5

LAKE NORTH, PALM BEACH COUNTY, FL 93

SEPT. 02, 2016
COPYRIGHT © 2016 ACKAL ARCHITECTS, APC.

SEPT. 02, 2016

COPYRIGHT © 2016 ACKAL ARCHITECTS, APC.
THIS DOCUMENT IS THE PROPERTY OF
ACKAL ARCHITECTS, APC.
THIS DOCUMENT MAY NOT BE COPIED,
REPRODUCED OR USED WITHOUT
WRITTEN CONSENT FROM
ACKAL ARCHITECTS, APC.

proj. no. 16-002 date: 08-02-2016

project architect:B.A. project manager: A.D. drawn by: MSA

file name: LAKEMORTH
revised: 3 ADDENDUM NO. 3, 04-02-2016
plot scale: AS NOTED
Sheet name:


LIGHTING PLAN

sheet no. =2.2

- 1. COORDINATE THE EXACT MOUNTING LOCATION OF ALL MECHANICAL EQUIPMENT WITH THE MECHANICAL CONTRACTOR.
- 2. REFER TO SHEET E2.0 FOR THE LOCATION OF ALL PANELS.

# SHEET NOTES:

- 1) EXTEND AND CONNECT CIRCUITING FROM JUNCTION BOX TO OUTLETS IN AREA WITH SAME CIRCUIT NUMBERS, ROUTE #12 CONDUCTORS (MINIMUM) THROUGHOUT, UNLESS NOTED OTHERWISE.
- 2 PROVIDE WEATHERPROOF MAINTENANCE RECEPTACLE MOUNTED ON 1/2" RGS RISER SECURELY MOUNTED TO ROOF STRUCTURE BELOW.
- PROVIDE CONNECTION FROM OUTDOOR UNIT TO INDOOR UNIT PER THE MANUFACTURER'S INSTALLATION INSTRUCTIONS.
- THE CONTRACTOR SHALL PROVIDE CONNECTION FROM OUTDOOR UNIT TO INDOOR UNIT. PROVIDE POWER AND CONTROL CONDUITS AND CONDUCTORS PER THE INSTALLED EQUIPMENT SHOP DRAWINGS. THIS SHALL INCLUDE, BUT IS NOT LIMITED TO 5 #14 CONDUCTORS FROM OUTDOOR CONDENSOR TO INDOOR DEFROST BOX AS WELL AS 2 #14 CONDUCTORS TO UNIT THERMOSTAT.

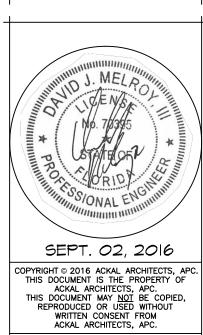

proj. no. 16-002

date: 08-02-2016

project architect:B.A. project manager: A.D. drawn by: MSA

file name:LAKEWORTH revised: 3 ADDBNDUM NO. 3, 04-02-2016 plot scale: AS NOTED sheet name: ELECTRICAL ROOF PLAN

sheet no.

42 of  $42_{\blacksquare}$ 

370 E. Windmill Lane, Suite 100 Las Vegas, NV. 89123 T: (702) 896-1100

MSA #L16029

ENGINEERING CONSULTANTS

# MECHANICAL/PLUMBING ABBREVIATIONS

NOTE: THIS IS A MASTER SCHEDULE. NOT ALL ABBREVIATIONS CONTAINED HEREIN MAY APPEAR ON THE DRAWINGS.

AABC	AMERICAN AIR BALANCE COUNCIL	GCO	GRADE CLEANOUT	PD	PRESSURE DROP
ACD	AUTOMATIC CONTROL DAMPER	GI	GREASE INTERCEPTOR	PRY	PRESSURE REDUCING VALVE
AFF		GPF	GALLONS PER FLUSH	PSI	POUNDS PER SQUARE INCH
aff AP	ABOVE FINISHED FLOOR	GPM	GALLONS PER MINUTE	PSIA	POUNDS PER SQUARE INCH
	ACCESS PANEL  AMERICAN SOCIETY OF HEATING,	GR GS	GLYCOL RETURN GLYCOL SUPPLY	PSID	ABSOLUTE POUNDS PER SQUARE INCH
	REFRIGERATION, AND AIR CONDITIONING ENGINEERS	GW	GREASE WASTE	PSIG	DIFFERENTIAL POUNDS PER SQUARE INCH
ASPE	AMERICAN SOCIETY OF PLUMBING ENGINEERS	HD	HEAD		GAUGE
AY	ACID VENT	HP	HORSEPOWER	(R)	EXISTING TO BE RELOCATED
AW AW	ACID WASTE	HPG	HIGH PRESSURE GAS	RA	RETURN AIR
		HR	HOUR	RH	RELATIVE HUMIDITY
BFD	BACKFLOW PREVENTION DEVICE	HSPF	HEATING SEASONAL PERFORMANCE FACTOR	RL/S	REFRIGERANT LIQUID/SUCTION
BHP n#::::	BRAKE HORSE POWER	HW	HOT WATER	RPM	REVOLUTIONS PER MINUTE
BTUH	BRITISH THERMAL UNIT PER HOUR	HWR	HEATING HOT WATER RETURN	RPPA	REDUCED PRESSURE PRINCIPA ASSEMBLY
CD	CONDENSATE DRAIN	HWS	HEATING HOT WATER SUPPLY	RVD	REMOTE VOLUME DAMPER
CFM	CUBIC FEET PER MINUTE	IBC	INTERNATIONAL BUILDING CODE	SA	SUPPLY AIR
CHAR	CHARACTERISTICS	IE	INVERT ELEVATION		
CHR	CHILLED WATER RETURN	iMC	INTERNATIONAL MECHANICAL	SD	SMOKE DAMPER
CHS	CHILLED WATER SUPPLY	11 10	CODE	SEER	SEASONAL ENERGY EFFICIENCY RATIO
co	CLEANOUT	IPC	INTERNATIONAL PLUMBING CODE	SOI	SAND OIL INTERCEPTOR
CR	CONDENSER WATER RETURN	KW	KILOWATT	"SP	STATIC PRESSURE (INCHES OF)
CS	CONDENSER WATER SUPPLY	LAT	LEAVING AIR TEMPERATURE	SPECS	SPECIFICATIONS
CW	COLD WATER	LBS	POUNDS	SQ	SQUARE
D	DRAIN	LWT	LEAVING WATER TEMPERATURE	SQFT	SQUARE FEET
DB	DRY BULB TEMPERATURE	MAX	MAXIMUM	SS	STAINLESS STEEL
DDC	DIRECT DIGITAL CONTROL	MBH	ONE THOUSAND BTUH	Ť	TEMPERATURE
DIA	DIAMETER	MCA	MINIMUM CIRCUIT AMPS	TAB	TEST AND BALANCE WORK AND
DN	DOWN	MIN	MINIMUM	·	REPORT
DΧ	DIRECT EXPANSION	MOCP	MAXIMUM OVER CURRENT PROTECTION	TSP TW	TOTAL STATIC PRESSURE TEMPERED WATER
(E)	EXISTING TO REMAIN	MPG	MEDIUM PRESSURE GAS		TYPICAL
EA	EXHAUST AIR	MYD	MANUAL VOLUME DAMPER	TYP	
EAT	ENTERING AIR TEMPERATURE	N/A	NOT APPLICABLE	UBC	UNIFORM BUILDING CODE
EC	ELECTRICAL CONTRACTOR	NC	NORMALLY CLOSED	UMC	UNIFORM MECHANICAL CODE
EER	ENERGY EFFICIENCY RATIO	NEBB	NATIONAL ENVIRONMENTAL	UON	UNLESS OTHERWISE NOTED
EFF	EFFICIENCY	NLDD	BALANCING BUREAU	UPC	UNIFORM PLUMBING CODE
ELEC	ELECTRICAL	NEC	NATIONAL ELECTRIC CODE	V (C) 1/1/17	VENT
ESP	EXTERNAL STATIC PRESSURE	NFPA	NATIONAL FIRE PROTECTION		VOLTAGE/PHASE/HERTZ
EWT	ENTERING WATER TEMPERATURE		ASSOCIATION	VFD	VARIABLE FREQUENCY DRIVE
<b>'</b> F	FAHRENHEIT	NIC	NOT IN CONTRACT	VTR WB	VENT THROUGH ROOF
<b>-</b> CO	FLOOR CLEANOUT	NO	NORMALLY OPEN	WB	WET BULB TEMPERATURE
<b>-</b> D	FIRE DAMPER	NTS	NOT TO SCALE	WCO	WALL CLEANOUT
FPM	FEET PER MINUTE	OA	OUTSIDE AIR	WG	WATER GAUGE
FSD	FIRE/6MOKE DAMPER	OAT	OUTSIDE AIR TEMPERATURE	WMS	WIRE MESH SCREEN
G	GAS	OBD	OPPOSED BLADE DAMPER	( <b>X</b> )	EXISTING TO BE REMOVED
GA	GAGE OR GAUGE	OED	OPEN END DUCT		


# SHEET NUMBER SHEET TITLE MP00 SYMBOL LIST AND ABBREVIATIONS MP01 SPECIFICATIONS MP02 MECHANICAL SCHEDULES MP03 PLUMBING SCHEDULES MP04 MECHANICAL AND PLUMBING DIAGRAMS MP05 MECHANICAL AND PLUMBING DIAGRAMS MP06 MECHANICAL AND PLUMBING DIAGRAMS MP07 MECHANICAL AND PLUMBING DIAGRAMS MP08 MECHANICAL AND PLUMBING DIAGRAMS MP09 MECHANICAL AND PLUMBING DIAGRAMS MP09 MECHANICAL AND PLUMBING DIAGRAMS MP09 MECHANICAL AND PLUMBING DIAGRAMS MP01 COMPLIANCE CERTIFICATE MP02 MECHANICAL AND PLUMBING DEMOLITION PLAN M20 MECHANICAL AND PLUMBING DEMOLITION PLAN M20 MECHANICAL PLAN P20 PLUMBING PLAN - WASTE AND VENT

PLUMBING PLAN - DOMESTIC WATER

TOTAL

MECHANICAL AND PLUMBING ROOF PLAN

DRAWING INDEX

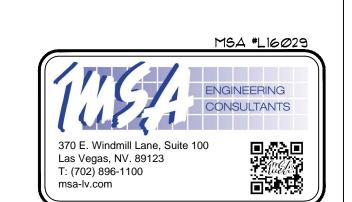

| 13 | 4 |

SEPT. 02, 2016

COPYRIGHT © 2016 ACKAL ARCHITECTS, APC.
THIS DOCUMENT IS THE PROPERTY OF
ACKAL ARCHITECTS, APC.
THIS DOCUMENT MAY NOT BE COPIED,
REPRODUCED OR USED WITHOUT
WRITTEN CONSENT FROM
ACKAL ARCHITECTS, APC.

proj. no. 16-002 date: 08-02-2016

project architect:B.A. project manager:A.D. drawn by:MSA

file name:LAKEWORTH
revised: 3 ADDRIVAN NO. 3, 04-02-2016
plot scale: AS NOTED
sheet name:
SYMBOL LIST AND
ABBREVIATIONS

sheet no.

	PACKAGED ELECTRIC ROOFTOP UNIT SCHEDULE																										
	GEI	NERAL DATA			SUPPLY	FAN DA	TΑ			CC	DOLING C	APACITY			ΕL	ECTRIC	HEATIN	G COIL				ELECT	RICAL DA	ΔΤ <i>Α</i>		OPERATING	
MARK	MANUFACTURER MODEL	LOCATION	SERVICE	SUPPLY AIR CFM	MIN. OUTSIDE AIR CFM	ESP (IN WG)	RPM	BHP	TOTAL (MBH)	SENSIBLE (MBH)	EAT (DB)	EAT (WB)	AMBIENT TEMP (°F)	SEER/ EER	TOTAL MBH	EAT (DB)	LAT (DB)	KW CON	O. OF NTROL TEPS	COMP. RLA	COND. FLA	EVAP. RLA	MCA	MOCP	V/₽H/HZ	WEIGHT (LBS)	REMARKS
RTU	TRANE WSCØ72	ROOF	WAITING	2400	36Ø	0.5	835	Ø.74	76.6	56.Ø	80.0	67.0	98/78	11.4	68.6	70	97.4	-	-	22.4	3.3	4.00	36.3	50.0	208/3/60	950	1, 2, 3, 4, 5, 6, 7, 8, 9, 10, 11
RTU 2	TRANE WSC <i>060</i>	ROOF	RECEPTION/ EXAM	2000	300	0.5	840	0.59	62.0	46.6	80.0	67.0	98/78	13.0	57.3	70	97.5	-	-	18.1	2.5	5.0	3Ø.2	45.0	208/3/60	360	1, 2, 3, 4, 5, 6, 7, 8, 9, 10, 11
RTU 3	TRANE WSC <i>090</i>	ROOF	DONOR FLOOR	3000	45Ø	0.5	697	0.90	92.4	68.3	80.0	67.0	98/78	- 11.1	83.2	7Ø	96.6	-	-	25.0	3.5	3.6	38.4	60.0	208/3/60	1020	1, 2, 3, 4, 5, 6, 7, 8, 9, 10, 11
RTU 4	TRANE WSC <i>090</i>	ROOF	DONOR FLOOR	3000	45Ø	0.5	697	0.90	92.4	68.3	80.0	67.0	98/78	- 11.1	83.2	70	96.6	-	-	25.0	3.5	3.6	38.4	60.0	208/3/60	1020	1, 2, 3, 4, 5, 6, 7, 8, 9, 10, 12
RTU 5	TRANE WSCØ48	ROOF	CONFERENCE/ BREAK ROOM	1600	275	0.5	916	0.56	49.0	3T.Ø	80.0	67.0	98/78	13.00	42.4	70	95.7	-	-	16.0	2.5	5.0	27.5	40.0	208/3/60	72Ø	1, 2, 3, 4, 5, 6, 7, 8, 10, 12
RTU 6	TRANE WSCØ48	ROOF	PLASMA PROCESSING	1600	200	0.5	916	0.56	49.0	3T.Ø	80.0	67.0	98/78	13.00	42.4	70	95.7	-	-	16.0	2.5	5.0	27.5	40.0	208/3/60	72Ø	1, 2, 3, 4, 5, 6, 7, 8, 10, 11
RTU 1	TRANE WSCØ36	ROOF	STERILE SUPPLIES	1200	18Ø	0.5	845	Ø.42	37.Ø	26.7	80.0	67.0	98/78	13.00	38.1	7Ø	100.7	-	-	13.5	2.00	5.0	23.8	35.0	208/3/60	700	1, 2, 3, 4, 5, 6, 7, 8, 10, 11
RTU	TRANE WSCØ36	ROOF	UNDEVELOPED SPACE	1200	180	Ø.5	845	Ø.42	37.Ø	26.7	80.0	67.0	98/78	13.00	38.1	70	100.7	-	-	13.5	2.00	5.0	23.8	35.0	208/3/60	700	1, 2, 3, 4, 5, 6, 7, 8, 10, 11

AIR CONDITIONING SYSTEM SHALL COMPLY CURRENT ADOPTED STANDARDS. PROVIDE 3/4" CONDENSATE DRAIN AND ROUTE TO APPROVED PLUMBING FIXTURE.

PROVIDE FLEX CONNECTION AT DUCT DROPS.

4. FAN SHALL OPERATE PER LIGHTING CONTROL

4. PROVIDE PROGRAMMABLE THERMOSTAT. 5. PROVIDE I" REPLACEABLE FILTER.

6. PROVIDE COMPARATIVE ENTHALPY ECONOMIZER WITH POWER EXHAUST.

7. SOUND RATING SHALL COMPLY WITH CURRENT ARI AND ANSI STANDARDS. 8. PROVIDE LOW AMBIENT KIT.

9. PROVIDE SMOKE DETECTOR IN RETURN AIR DUCT.
10. PROVIDE SINGLE POINT OF POWER CONNECTION.

 $\underline{\$}$ 

12. PROVIDE HIGH WIND LOAD ADAPTER CURB AS REQUIRED AT EXISTING ROOF CURB DESIGNED BY STRUCTURAL AND SUBMITTED BY THE MANUFACTURER.

SUBMITTED BY THE MANUFACTURER.

11. PROVIDE 14" HIGH WIND LOAD ROOF CURB DESIGNED BY STRUCTURAL AND

				DUC	TLE	:66	SP		JR .	CON	IDITI	ON	NG	; S'	YS'	TEM	SC	HED	ULE					
M,	1ARK						COOLING CAPACITY						INDOOR ELECTRICAL							OUTDOOR ELECTRICAL			OUTDOOR	
FAN COIL	COND	MANUFACTURER	INDOOR MODEL	OUTDOOR MODEL	CFM	ESP (IN WC.	TOTAL MBH	SENSIBLE MBH	IND( EAT (DB)	OOR EAT (WB)	OUTDOOR (DB)	SEER	FLA	WATT	6 HP	V/PH/HZ	MCA	MOCP	V/PH/HZ	MCA		OPERATING WEIGHT (LBS)	OPERATING WEIGHT (LBS)	REMARKS
FC 1	<del>-</del>	FUJITSU	ASU18RL	AOU18RL	600	Ø.2	18.0	11.5	80.0	67.0	95°F	19.0	-	42	-	-	-	-	208/1/60	13.5	20	25	15Ø	1, 2, 3, 4, 5, 6
		INE VOLTAGE THERM OW AMBIENT KIT FOR						DRIVEN TWIN DENGATE PU		COMPR	=560R	5.		1DE SIN 20RUNI		NT POWER	CONE	ECTION AT		6.	OR EQUA	L.		

	G	ENERAL DATA			F	AN			ELEC	CTRICAL			
1ARK	MANUFACTURER MODEL	LOCATION	SERVICE	TYPE	CFM	ESP (IN WG)	RPM	BHP	HP (W)	FLA	V/PH/HZ	OPERATING WEIGHT (LBS)	REMARKS
EF 1	GREENHECK G-095-VG	ROOF	LOBBY RESTROOMS	CENT	400	0.5	1725	-	1/6	3.4	120/1/60	3Ø	1, 2, 3, 4, 5, 6, 7, 8
EF 2	GREENHECK G-095-VG	ROOF	EMPLOYEE RESTROOMS	CENT	300	Ø.5	1725	-	1/6	3.4	120/1/60	3Ø	1, 2, 3, 4, 5, 6, 7, 8
EF 3	BROAN QTXEI5Ø	CEILING	JANITOR	CENT	125	Ø.15	-	-	(51.3)	Ø.5	115/1/60	25	1, 2, 3, 4, 6, 7, 8

DUC	tless	SPLI	TAIR	CON		ONIN	ig s	rstem	SCHEE	DULE						Alf	R DIST	RIBUT	ION S	BCHEL	DULE	
COOLING CAPACITY  R OUTDOOR L MODEL CFM (IN WC) TOTAL SENSIBLE EAT EAT							IN.	DOOR ELEC	TRICAL	OUTDOOR ELEC	CTRICAL	OPERATING			MARK	MANUFACTURER MODEL	AIRFLOW RANGE	SERVICE TYPE	MAX NC	NECK SIZE	PANEL SIZE	REMARK
MODEL	(IN WC)	MBH M	BIBLE EAT (DB)	EAT (WB)	OUTDOOR (DB)	SEER FL	_A WATTE	HP V/PH/A	HZ MCA MOCE	P V/PH/HZ MCA	MOCP	WEIGHT (LBS)	WEIGHT (LBS)	REITARNS	D-I CFM	TITUS TMS	0 - 100	SUPPLY - SURFACE	30	6"¢	12"×12"	1, 3
_ AOUISRL	600 0.2	18.0	1.5 80.0	67.0	95°F	19.0	- 42			208/1/60 13.5	2Ø	25	150	1, 2, 3, 4, 5, 6	D-2 CFM	TITUS	0 - 100	SUPPLY -	3Ø	6"¢	12"×12"	1, 3
	· ·	ÆRTER-DRIV DE CONDENG	EN TWIN ROTAR ATE PUMP.	Y COMPRES	660R		ROMDE SINC ITDOOR UNIT		ER CONNECTION A	AT 6. (	OR EQUA	<b>N_</b> .			D-3 CFM	TMS TITUS TMS	101-200	SUPPLY - LAY-IN	3Ø	8"¢	24"×24"	1, 3
					4 -			II <del>=</del>							D-4 CFM	TITUS TMS	2Ø1-38Ø	SUPPLY - LAY-IN	3Ø	<b>Ι</b> Ø"Φ	24"×24"	1, 3
EXHAUST FAN SCHEDULE													D-5 CFM	TITUS TMS	381-600	SUPPLY - LAY-IN	3Ø	12"¢	24"×24"	1, 3		
N SERVI	ICE TYPE	E CFM	ESP (IN WG)	RPM	BHP	HP (W)	FLA	V/PH/HZ	OPERATING WEIGHT (LBS)		REMARKS				D-6	TITUS 300FS	2Ø1-38Ø	SUPPLY - SIDEWALL	3Ø	12"×6"	15"×9"	1, 2
LOBE RESTRO		T 400	0.5	1725	-	1/6	3.4	120/1/60	3Ø		1,	2, 3, 4, 5, 6,	7, 8		R-1 CFM	TITUS 5ØF	100 - 200	RETURN - LAY-IN	3Ø	8"X8"	24"×24"	1, 3
EMPLO RESTRO		Т 300	0.5	1725	-	1/6	3.4	120/1/60	3Ø		1,	1, 2, 3, 4, 5, 6, 7, 8			R-2 CFM	TITUS 5ØF	201 - 380	RETURN - LAY-IN	3Ø	1Ø"×1Ø"	24"×24"	1, 3
JANITO	OR CENT	125	Ø.15	-	-	(51.3)	Ø.5	115/1/60	25			1, 2, 3, 4, 6, 7	, 8		R-3 CFM	TITUS 5ØF	381 - 6 <i>00</i>	RETURN -	3Ø	12"×12"	24"×24"	1, 3
ERLOADS.	INFORM 5. PROVI	MATION. IDE ROOF (				8. NO	NTRIFUGA	.OADING, BA L FAN WHEEL	CKWARD INCLIN ,, STATICALLY &						R-4 CFM	TITUS 5ØF	601 - 300	RETURN - LAY-IN	3Ø	14"×14"	24"×24"	1, 3
CONTROL			RHOOD WITH						ED PER AMCA 6	1D. 204	~~~	~~~~	· · · · · · · · · · · · · · · · · · ·	~~~~~	R-5 CFM	TITUS 5ØF	901 - 1200	RETURN - LAY-IN	3Ø	16"X16"	24"×24"	1, 3
															EX-1	TITUS		EXHAUST -				

PROVIDE OBD.
PROVIDE DUCT TRANSITION AS REQUIRED.

SEPT. 02, 2016 COPYRIGHT © 2016 ACKAL ARCHITECTS, APC.
THIS DOCUMENT IS THE PROPERTY OF
ACKAL ARCHITECTS, APC.
THIS DOCUMENT MAY NOT BE COPIED,
REPRODUCED OR USED WITHOUT
WRITTEN CONSENT FROM
ACKAL ARCHITECTS, APC.

proj. no. 16-002 date: 08-02-2016

project architect:B.A. project manager: A.D. drawn by: MSA

file name:LAKEWORTH revised: 🖄 ADDENDUM NO. 3, 09-02-2016 plot scale: AS NOTED |sheet name: MECHANICAL SCHEDULES

sheet no.


22 of 42

MSA #L16029 ENGINEERING CONSULTANTS 370 E. Windmill Lane, Suite 100 Las Vegas, NV. 89123 T: (702) 896-1100

- ACCESS DOORS ARE REQUIRED FOR ALL DAMPERS INSTALLED ABOVE INACCESSIBLE CEILINGS. COORDINATE EXACT LOCATION OF ALL ACCESS DOORS WITH ARCHITECT PRIOR TO INSTALLATION.
- 2. VERIFY LOCATION OF ALL THERMOSTATS WITH ARCHITECT PRIOR TO INSTALLATION. MOUNT ALL THERMOSTATS @48" A.F.F. IN ACCORDANCE WITH ADA STANDARDS. PROVIDE LOCKING COVERS FOR T-STATS.
- 3. VERIFY AND COORDINATE FRAME AND BORDER TYPE REQUIREMENTS FOR AIR DEVICES WITH ARCHITECTURAL CEILING PLANS PRIOR TO ORDERING.
- 4. DUCT SIZES SHOWN ARE THE CLEAR INSIDE DIMENSIONS.
- 5. THE MECHANICAL CONTRACTOR SHALL VERIFY THE LOCATION OF ALL ROOF MOUNTED EQUIPMENT AND ROOF PENETRATIONS WITH ARCHITECT AND STRUCTURAL ENGINEER PRIOR TO COMMENCING WORK.
- 6. THE MECHANICAL CONTRACTOR SHALL COORDINATE LOCATION AND ROUTING OF HVAC EQUIPMENT AND DUCTWORK WITH OTHER TRADES PRIOR TO COMMENCING WORK.
- 7. ALL EXHAUST OUTLETS SHALL BE LOCATED MIN. OF 10'-0" FROM ANY OUTSIDE AIR INTAKES.
- 8. THE CUTTING, NOTCHING AND BORING OF HOLES IN FLOOR JOIST AND WALL STUDS SHALL BE IN ACCORDANCE WITH THE LATEST APPROVED EDITION OF THE INTERNATIONAL BUILDING CODE.
- 9. CONTRACTOR SHALL BE RESPONSIBLE FOR ALL CUTTING AND PATCHING AS REQUIRED TO ACCOMMODATE HIS WORK.
- 10. REFER TO THE MECHANICAL DIAGRAMS THAT APPLY TO THE WORK ON THIS DRAWING. THESE DIAGRAMS PROVIDE GUIDANCE AS TO INSTALLATION INTENT AND DO NOT NECESSARILY SHOW ALL COMPONENTS REQUIRED.


## SHEET NOTES:

- 10"XI0" EXHAUST DUCT UP THROUGH ROOF TO <u>EF-1/EF-2</u>. PROVIDE DUCT TRANSITION AS REQUIRED TO INLET OF FAN.
- (2) 8" EXHAUST DUCT UP THROUGH ROOF.

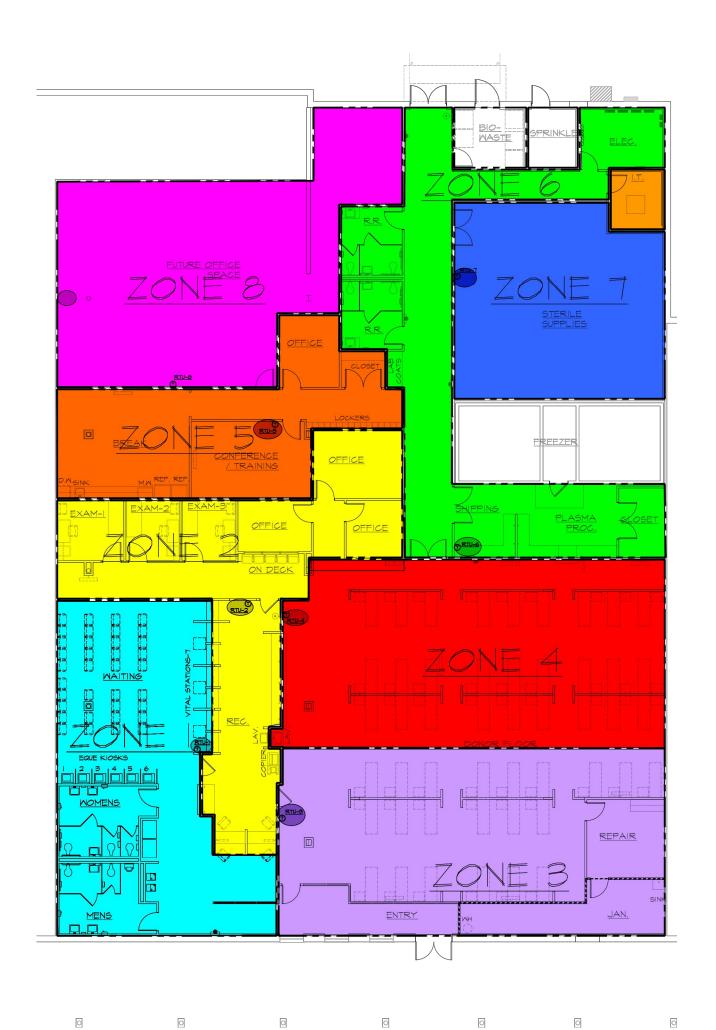





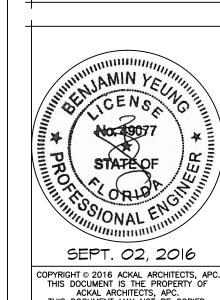

proj. no. 16-002

date: 08-02-2016 project architect:B.A. project manager: A.D.

drawn by: MSA file name:LAKEWORTH revised: (3) ADDENDUM NO. 3, 04-02-2016 plot scale: AS NOTED sheet name:

MECHANICAL PLAN

sheet no.

29 of 42



(ON ROOF)

D-6 18"X12"

8"¢— D-3 100

1020

(ON ROOF)

ADJACENT

TENANT

(ON ROOF)

D-6

(ON ROOF)

D-4 250

—12"×14[†]⊘

(ON ROOF)

CANOPY

1100

ΦN ROOF

გ"¢√r | R-1 |

D-4 375

180 TOF3

12"4

R-4 850

D-4 375

(ON ROOF)

R-4 850 4 F C

200

____

—1Ø"¢

D-2

D-4 375

D-4

375

D-4 320

D-3 200

 $\bigcirc$ 

ADJACENT TENANT

160

300

200

10"¢

SUPPLIES

TO COMMENCING WORK.

1. REFER TO PLUMBING PLANS FOR SIZES AND ROUTING OF CONDENSATE

- 2. THE MECHANICAL/PLUMBING CONTRACTOR SHALL VERIFY THE LOCATION OF ALL ROOF MOUNTED EQUIPMENT AND ROOF PENETRATIONS WITH ARCHITECT AND STRUCTURAL ENGINEER PRIOR TO COMMENCING WORK.
- 3. THE MECHANICAL CONTRACTOR SHALL COORDINATE LOCATION AND ROUTING OF HVAC EQUIPMENT AND DUCTWORK WITH OTHER TRADES PRIOR
- 4. OUTSIDE AIR INTAKE A MINIMUM OF 10'-0" AWAY FROM TOILET EXHAUST.
- 5. ALL WATER PIPING SHALL BE INSTALLED ON THE INTERIOR SIDE OF THE BUILDING UNLESS PROTECTED FROM FREEZING.
- 6. THE CUTTING, NOTCHING AND BORING OF HOLES IN FLOOR JOIST AND WALL STUDS SHALL BE IN ACCORDANCE WITH THE LATEST APPROVED EDITION OF THE INTERNATIONAL BUILDING CODE.
- 7. CONTRACTOR SHALL BE RESPONSIBLE FOR THE COORDINATION OF ALL PLUMBING ROUGH-IN LOCATIONS. REFER TO ARCHITECTURAL DRAWINGS FOR FIXTURES AND EQUIPMENT LOCATIONS.
- 8. CONTRACTOR SHALL BE RESPONSIBLE FOR ALL CUTTING AND PATCHING AS REQUIRED TO ACCOMMODATE HIS WORK.
- 9. ALL SANITARY DRAINAGE PIPING SHALL BE SLOPED AT 1/4" PER FOOT.
- 10. REFER TO THE MECHANICAL AND PLUMBING DIAGRAMS THAT APPLY TO THE WORK ON THIS DRAWING. THESE DIAGRAMS PROVIDE GUIDANCE AS TO INSTALLATION INTENT AND DO NOT NECESSARILY SHOW ALL COMPONENTS REQUIRED.

# SHEET NOTES:

(1) 2" VENT THROUGH ROOF.


 $\langle 2 \rangle$  3" VENT THROUGH ROOF.

 $\langle 3 
angle$  3/4" CW DOWN THROUGH ROOF. FOR CONTINUATION REFER TO SHEET P2.1.

4 RUN FULL SIZE CONDENSATE DRAIN TO NEAREST ROOF GUTTER, FIELD VERIFY ROUTING, AND LOCATION.

(5) ROOFTOP FREEZER CONDENSING UNITS BY OTHERS. REFER TO REFRIGERATION CONTRACTOR FOR MORE INFORMATION.

6 8" BATHROOM EXHAUST DUCT THROUGH ROOF TO GOOSENECK WITH INSECT SCREEN. FIELD VERIFY EXACT ROUTING AND LOCATION.

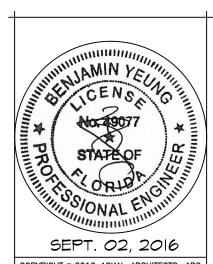

COPYRIGHT © 2016 ACKAL ARCHITECTS, APC.
THIS DOCUMENT IS THE PROPERTY OF
ACKAL ARCHITECTS, APC.
THIS DOCUMENT MAY <u>NOT</u> BE COPIED,
REPRODUCED OR USED WITHOUT
WRITTEN CONSENT FROM
ACKAL ARCHITECTS, APC.

proj. no. 16-002 date: 08-02-2016

project architect:B.A project manager: A.D drawn by: MSA

file name:LAKEWORTH revised: 3 ADDENDUM NO. 3, 04-02-2016 plot scale: AS NOTED sheet name: MECHANICAL AND PLUMBING ROOF PLAN

sheet no.

MSA #L16029

ENGINEERING CONSULTANTS

370 E. Windmill Lane, Suite 100 Las Vegas, NV. 89123 T: (702) 896-1100

32 of 42